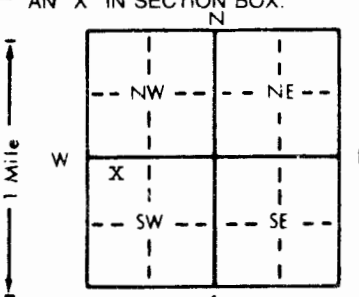


1 LOCATION OF WATER WELL: Fraction NE 1/4 NW 1/4 SW 1/4 Section Number 11 Township Number T 31 S Range Number R 6

Distance and direction from nearest town or city street address of well if located within city?
2 miles west 1 mi North of RUNNEY MEADE, Kans.

2 WATER WELL OWNER: Jeff Blubaugh
RR#, St. Address, Box #: Box 23
City, State, ZIP Code: Danville, Kans. 67036
Board of Agriculture, Division of Water Resources
Application Number:

3 LOCATE WELL'S LOCATION WITH AN "X" IN SECTION BOX:


4 DEPTH OF COMPLETED WELL: 50' ft. ELEVATION:
 Depth(s) Groundwater Encountered 1. 17' ft. 2. ft. 3. ft.
 WELL'S STATIC WATER LEVEL: 17' ft. below land surface measured on mo/day/yr Aug. 22, 1994
 Pump test data: Well water was NA ft. after hours pumping gpm
 Est. Yield: 12 gpm; Well water was ft. after hours pumping gpm
 Bore Hole Diameter: 7 7/8 in. to 50' ft. and in. to ft.
 WELL WATER TO BE USED AS:
 Domestic 3 Feedlot 6 Oil field water supply 9 Dewatering 12 Other (Specify below)
 2 Irrigation 4 Industrial 7 Lawn and garden only 10 Monitoring well
 Was a chemical/bacteriological sample submitted to Department? Yes No; If yes, mo/day/yr sample was submitted
 Water Well Disinfected? Yes No

5 TYPE OF BLANK CASING USED:
 1 Steel 3 RMP (SR) 5 Wrought iron 8 Concrete tile CASING JOINTS: Glued Clamped
 2 PVC 4 ABS 6 Asbestos-Cement 9 Other (specify below) Welded
 7 Fiberglass Threaded
 Blank casing diameter: 5" in. to 30' ft., Dia. in. to ft., Dia. in. to ft.
 Casing height above land surface: 16" in., weight 160 lbs./ft. Wall thickness or gauge No. SDR 26
 TYPE OF SCREEN OR PERFORATION MATERIAL:
 7 PVC 10 Asbestos-cement
 1 Steel 3 Stainless steel 5 Fiberglass 8 RMP (SR) 11 Other (specify)
 2 Brass 4 Galvanized steel 6 Concrete tile 9 ABS 12 None used (open hole)
 SCREEN OR PERFORATION OPENINGS ARE:
 5 Gauzed wrapped 8 Saw cut 11 None (open hole)
 1 Continuous slot 3 Mill slot 6 Wire wrapped 9 Drilled holes
 2 Louvered shutter 4 Key punched 7 Torch cut 10 Other (specify)
 SCREEN-PERFORATED INTERVALS: From 50' ft. to 30' ft., From ft. to ft.
 GRAVEL PACK INTERVALS: From 50' ft. to 23' ft., From ft. to ft.

6 GROUT MATERIAL: 1 Neat cement 2 Cement grout 3 Bentonite 4 Other
 Grout intervals: From 23' ft. to 3' ft., From ft. to ft., From ft. to ft.
 What is the nearest source of possible contamination:
 10 Livestock pens 14 Abandoned water well
 1 Septic tank 4 Lateral lines 7 Pit privy 11 Fuel storage 15 Oil well/Gas well
 2 Sewer lines 5 Cess pool 8 Sewage lagoon 12 Fertilizer storage 16 Other (specify below)
 3 Watertight sewer lines 6 Seepage pit 9 Feedyard 13 Insecticide storage
 Direction from well? SW How many feet? App. 1320'

FROM	TO	LITHOLOGIC LOG	FROM	TO	PLUGGING INTERVALS
0'	6'	top soil (Loose)			
6'	11'	Clay.			
11'	17'	Sandy Clay.			
17'	28'	Broken Sand Strips w/Clay.			
28'	39'	Clay balls (round).			
39'	50'	Broken RED & Green Shale.			
	50'	Solid Red Bed Or Shale.			

7 CONTRACTOR'S OR LANDOWNER'S CERTIFICATION: This water well was (1) constructed, (2) reconstructed, or (3) plugged under my jurisdiction and was completed on (mo/day/year) Aug 17 1994 and this record is true to the best of my knowledge and belief. Kansas Water Well Contractor's License No. 112 This Water Well Record was completed on (mo/day/yr) Sept 16 1994 under the business name of Wells Drilling Co. by (signature) Dal Wells

OFFICE USE ONLY
T
R
EW
SEC.
1/4
1/4
1/4