


1 LOCATION OF WATER WELL: County: Harper	Fraction C-NW $\frac{1}{4}$ SW $\frac{1}{4}$ SW $\frac{1}{4}$	Section Number 8	Township Number T 31 S	Range Number R 7 E/W
--	--	----------------------------	----------------------------------	--------------------------------

Distance and direction from nearest town or city street address of well if located within city?
2-W, 2-S of Duquoin, Ks.

2 WATER WELL OWNER: RR#, St. Address, Box # : City, State, ZIP Code	Bill Graves Wichita, KS Great Bend, KS 67530	Lobo Drilling Co. P.O. Box 877 67530 Board of Agriculture, Division of Water Resources Application Number: 900520
---	---	---

3 LOCATE WELL'S LOCATION WITH AN "X" IN SECTION BOX:

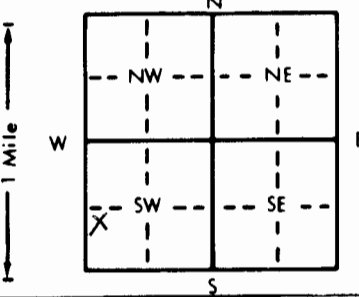

4 DEPTH OF COMPLETED WELL: 105 ft. ELEVATION: unknown	Depth(s) Groundwater Encountered 1. 50 ft. 2. _____ ft. 3. _____ ft.
WELL'S STATIC WATER LEVEL 50 ft. below land surface measured on 11-17-90 mo/day/yr	
Pump test data: Well water was _____ ft. after _____ hours pumping _____ gpm	
Est. Yield 60 gpm: Well water was _____ ft. after _____ hours pumping _____ gpm	
Bore Hole Diameter 8 in. to 105 ft., and _____ in. to _____ ft.	
WELL WATER TO BE USED AS:	
5 Public water supply	8 Air conditioning
11 Injection well	12 Other (Specify below)
1 Domestic	3 Feedlot
<input checked="" type="checkbox"/> Oil field water supply	9 Dewatering
2 Irrigation	4 Industrial
7 Lawn and garden only	10 Monitoring well
Was a chemical/bacteriological sample submitted to Department? Yes _____ No <input checked="" type="checkbox"/> ; If yes, mo/day/yr sample was submitted _____	
Water Well Disinfected? Yes _____ No <input checked="" type="checkbox"/>	

5 TYPE OF BLANK CASING USED:	5 Wrought iron	8 Concrete tile	CASING JOINTS: Glued <input checked="" type="checkbox"/> Clamped _____
1 Steel	3 RMP (SR)	6 Asbestos-Cement	9 Other (specify below)
<input checked="" type="checkbox"/> PVC	4 ABS	7 Fiberglass	Welded _____
Blank casing diameter 5 in. to 85 ft., Dia _____ in. to _____ ft., Dia _____ in. to _____ ft.	Threaded _____		
Casing height above land surface 12 in., weight 2.8 lbs./ft. Wall thickness or gauge No. _____			

TYPE OF SCREEN OR PERFORATION MATERIAL:	4 PVC	10 Asbestos-cement
1 Steel	3 Stainless steel	5 Fiberglass
2 Brass	4 Galvanized steel	8 RMP (SR)
6 Concrete tile	9 ABS	11 Other (specify) _____
12 None used (open hole)		

SCREEN OR PERFORATION OPENINGS ARE:	5 Gauzed wrapped	6 Saw cut
1 Continuous slot	3 Mill slot	11 None (open hole)
2 Louvered shutter	4 Key punched	6 Wire wrapped
7 Torch cut	10 Other (specify) _____	9 Drilled holes

SCREEN-PERFORATED INTERVALS:	From 85 ft. to 105 ft., From _____ ft. to _____ ft.	From _____ ft. to _____ ft., From _____ ft. to _____ ft.
GRAVEL PACK INTERVALS:	From 20 ft. to 105 ft., From _____ ft. to _____ ft.	From _____ ft. to _____ ft., From _____ ft. to _____ ft.

6 GROUT MATERIAL:	1 Neat cement	2 Cement grout
Grout Intervals: From 0 ft. to 20 ft., From _____ ft. to _____ ft., From _____ ft. to _____ ft.	3 Bentonite	4 Other _____
What is the nearest source of possible contamination:	10 Livestock pens	14 Abandoned water well
1 Septic tank	4 Lateral lines	7 Pit privy
2 Sewer lines	5 Cess pool	8 Sewage lagoon
3 Watertight sewer lines	6 Seepage pit	9 Feedyard
11 Fuel storage	12 Fertilizer storage	16 Other (specify below)
13 Insecticide storage	60	
Direction from well? South	How many feet? 60	

FROM	TO	LITHOLOGIC LOG	FROM	TO	PLUGGING INTERVALS
0	70	Sandy Clay	105	3	cement
70	105	Sand & Gravel	3	0	top soil

7 CONTRACTOR'S OR LANDOWNER'S CERTIFICATION: This water well was (1) constructed, (2) reconstructed, or (3) plugged under my jurisdiction and was completed on (mo/day/year) 11-26-90 and this record is true to the best of my knowledge and belief. Kansas Water Well Contractor's License No. _____ This Water Well Record was completed on (mo/day/yr) 08-29-91 under the business name of LOBO Drilling/oil wellcontractor by (signature) <i>[Signature]</i>
--

OFFICE USE ONLY
T
R
EW
SEC.