

#2

WATER WELL RECORD

Form WWC-5

Division of Water Resources App. No.


Blank box for application number

1 LOCATION OF WATER WELL: County: Harper, Fraction SW 1/4 SW 1/4 SW 1/4 1/4, Section Number 5, Township No T 31S, Range Number R 7 E NW

Street/Rural Address of Well Location; if unknown, distance & direction from nearest town or intersection: If at owner's address, check here. 1/4 mi E of NE 90th ave / 150th Rd

Global Positioning System (GPS) information: Latitude, Longitude, Elevation, Datum, Collection Method

2 WATER WELL OWNER: John messenger, RR#, Street Address, Box #: 1728 SE 30th St, City, State, ZIP Code: Kingman, Ks 67068

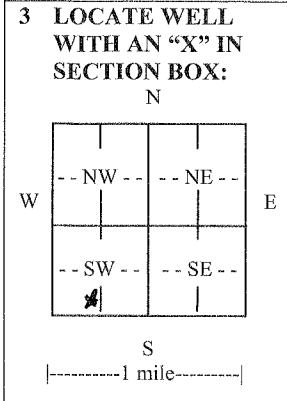

4 DEPTH OF COMPLETED WELL 130 ft. Depth(s) Groundwater Encountered, WELL'S STATIC WATER LEVEL 63 ft., Pump test data, EST. YIELD, Bore Hole Diameter 14 in. to 130 ft., WELL WATER TO BE USED AS: Domestic-lawn & garden, Was a chemical/bacteriological sample submitted?, Water well disinfected? Yes


5 TYPE OF CASING USED: PVC, CASING JOINTS: Glued, Casing diameter 8 in. to 130 ft., Casing height above land surface 16 in., TYPE OF SCREEN OR PERFORATION MATERIAL: PVC, SCREEN OR PERFORATION OPENINGS ARE: Mill slot, SCREEN-PERFORATED INTERVALS: 80 ft. to 130 ft., GRAVEL PACK INTERVALS: 24 ft. to 130 ft.

6 GROUT MATERIAL: Bentonite, Grout Intervals: 4 ft. to 24 ft., What is the nearest source of possible contamination: Nothing within 1/4 mi. All

Table with columns: FROM, TO, LITHOLOGIC LOG, FROM, TO, LITHO. LOG (cont.) or PLUGGING INTERVALS. Rows: 0-2 Topsoil, 2-13 Sandy Clay Med sand, 13-42 Med coarse sand & gravel, 42-63 Clay Tan, 63-117 Sand & Gravel - Med to coarse, 117-121 Red clay, 121-130 Red shale

7 CONTRACTOR'S OR LANDOWNER'S CERTIFICATION: This water well was constructed, reconstructed, or plugged under my jurisdiction and was completed on (mo/day/year) 2.2.12 and this record is true to the best of my knowledge and belief. Kansas Water Well Contractor's License No. 611, This Water Well Record was completed on (mo/day/year) 2.13.12 under the business name of Chase Drilling by (signature) D. Chase

INSTRUCTIONS: Use typewriter or ball point pen. PLEASE PRESS FIRMLY and PRINT clearly. Please fill in blanks and check the correct answers. Send three copies (white, blue, pink) to Kansas Department of Health and Environment, Bureau of Water, Geology Section, 1000 SW Jackson St., Suite 420, Topeka, Kansas 66612-1367. Telephone 785-296-5524. Send one copy to WATER WELL OWNER and retain one for your records. Include fee of \$5.00 for each constructed well. Visit us at http://www.kdheks.gov/waterwell/index.html.

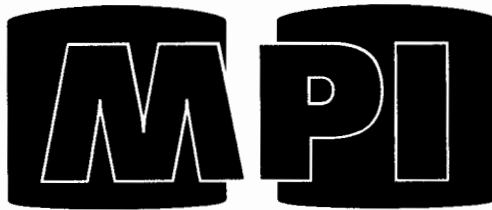

**MESSENGER PETROLEUM, INC.**

## WATER WELL ACCEPTANCE AGREEMENT

Water Well Name: JoHo-Coleman  
Water Well Location: S/2 SW SW Sec 5-31s-7w Harper Co., KS  
Application #: 20120008 00

This Agreement between **Messenger Petroleum, Inc.**, 525 S. Main, Kingman, KS, 67068 (grantor) AND **JoHo LLC**, 1728 SE 30 St, Kingman KS, 6706 (grantee), certifies that they accept the above listed water well that was drilled at the above stated location. When the water well is no longer needed by JoHo LLC, JoHo LLC agrees to plug this well in accordance with State regulation.

By signing this Agreement, landowner releases Messenger Petroleum, Inc. from any liability and responsibilities relating to the water well described above.

Handwritten signature of Nacona Dick in black ink.

Nacona Dick, Office Manager  
Messenger Petroleum, Inc.

4-07-12

Handwritten signature of Jon F. Messenger in black ink.

Jon F. Messenger, Manager for JoHo LLC

4-07-12