

WATER WELL RECORD Form WWC-5 KSA 82a-1212


1 LOCATION OF WATER WELL: County: Harper	Fraction SE 1/4 SW SE 1/4 SW 1/4	Section Number 1	Township Number T 31 S	Range Number R 8 E/W
--	--	----------------------------	----------------------------------	--------------------------------

Distance and direction from nearest town or city street address of well if located within city?
18 Miles South, 3 3/4 Miles West of Kingman, Kans.

2 WATER WELL OWNER: **Susie ~~Hensiek~~ Hensiek**
 RR#, St. Address, Box # : **568 N.W. 150th Rd.**
 City, State, ZIP Code : **Harper, Kansas 67508**

Board of Agriculture, Division of Water Resources
Application Number:

3 LOCATE WELL'S LOCATION WITH AN "X" IN SECTION BOX:

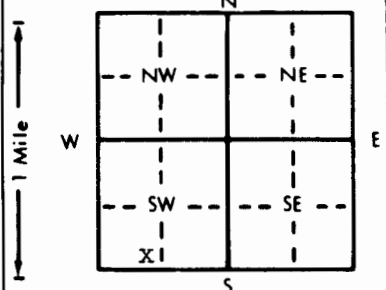

4 DEPTH OF COMPLETED WELL: **97'** ft. ELEVATION: _____

Depth(s) Groundwater Encountered **1. 72'** ft. 2. _____ ft. 3. _____ ft.

WELL'S STATIC WATER LEVEL **72'** ft. below land surface measured on mo/day/yr **Oct. 24-95**

Pump test data: Well water was _____ ft. after _____ hours pumping _____ gpm

Est. Yield **12** gpm: Well water was _____ ft. after _____ hours pumping _____ gpm

Bore Hole Diameter **7 7/8"** in. to **97'** ft., and _____ in. to _____ ft.

WELL WATER TO BE USED AS:

5 Public water supply	8 Air conditioning	11 Injection well
XX1 Domestic	3 Feedlot	6 Oil field water supply
9 Dewatering	12 Other (Specify below)	
2 Irrigation	4 Industrial	7 Lawn and garden only
10 Monitoring well		

Was a chemical/bacteriological sample submitted to Department? Yes _____ No **XX**; If yes, mo/day/yr sample was submitted _____

Water Well Disinfected? Yes **XX** No

5 TYPE OF BLANK CASING USED:

1 Steel	3 RMP (SR)	5 Wrought iron	8 Concrete tile	CASING JOINTS: Glued XX Clamped _____
XX2 PVC	4 ABS	6 Asbestos-Cement	9 Other (specify below)	Welded _____
		7 Fiberglass		Threaded _____

Blank casing diameter **5"** in. to **72'** ft., Dia _____ in. to _____ ft., Dia _____ in. to _____ ft.

Casing height above land surface **14"** in., weight **160** lbs./ft. Wall thickness or gauge No. **SDR 26**

TYPE OF SCREEN OR PERFORATION MATERIAL:

1 Steel	3 Stainless steel	5 Fiberglass	8 RMP (SR)	10 Asbestos-cement
2 Brass	4 Galvanized steel	6 Concrete tile	9 ABS	11 Other (specify) _____
				12 None used (open hole)

SCREEN OR PERFORATION OPENINGS ARE:

1 Continuous slot	3 Mill slot	5 Gauzed wrapped	XX8 Saw cut	11 None (open hole)
2 Louvered shutter	4 Key punched	6 Wire wrapped	9 Drilled holes	
		7 Torch cut	10 Other (specify) _____	

SCREEN-PERFORATED INTERVALS: From **97'** ft. to **72'** ft., From _____ ft. to _____ ft.

GRAVEL PACK INTERVALS: From **97'** ft. to **64'** ft., From **52'** ft. to **23'** ft.

6 GROUT MATERIAL: 1 Neat cement 2 Cement grout **XX8** Bentonite 4 Other _____

Grout Intervals: From **64'** ft. to **52'** ft., From **23'** ft. to **19'** ft., From _____ ft. to _____ ft.

What is the nearest source of possible contamination:

1 Septic tank	4 Lateral lines	7 Pit privy	10 Livestock pens	XX14 Abandoned water well
2 Sewer lines	5 Cess pool	8 Sewage lagoon	11 Fuel storage	15 Oil well/Gas well
3 Watertight sewer lines	6 Seepage pit	9 Feedyard	12 Fertilizer storage	16 Other (specify below)
			13 Insecticide storage	

Direction from well? **SE**

How many feet? **App. 180'**

FROM	TO	LITHOLOGIC LOG	FROM	TO	PLUGGING INTERVALS
0'	2'	Top soil.			
2'	9'	Clay.			
9'	32'	Course sand & Gravel.			
32'	41'	Grey Clay.			
41'	64'	Brown Clay.			
64'	72'	Brown Clay W/ Sand strips.			
72'	96'	Course Sand (Clean).			
96'	97'	Hard Clay.			

7 CONTRACTOR'S OR LANDOWNER'S CERTIFICATION: This water well was (1) constructed, (2) reconstructed, or (3) plugged under my jurisdiction and was completed on (mo/day/year) **Oct. 24 - 1995** and this record is true to the best of my knowledge and belief. Kansas Water Well Contractor's License No. **112** This Water Well Record was completed on (mo/day/yr) **Nov. 8 - 1995** under the business name of **Wells Drilling Co.** by (signature) *Wal Wells*

INSTRUCTIONS: Use typewriter or ball point pen. PLEASE PRESS FIRMLY and PRINT clearly. Please fill in blanks, underline or circle the correct answers. Send top three copies to Kansas Department of Health and Environment, Bureau of Water, Topeka, Kansas 66620-0001. Telephone: 913-296-5545. Send one to WATER WELL OWNER and retain one for your records.