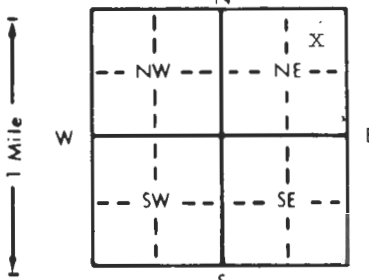


1 LOCATION OF WATER WELL: Fraction NW 1/4 NE 1/4 NE 1/4 Section Number 14 Township Number T 31 S Range Number R 8 ~~12W~~
 County: Harper

Distance and direction from nearest town or city street address of well if located within city?
 18 Miles South, 4 Miles West, 1 Mile South, 1/4 Mile West Of Kingman, Kans.

2 WATER WELL OWNER: Bob Culver
 RR#, St. Address, Box # : RT#3 Board of Agriculture, Division of Water Resources
 City, State, ZIP Code : Harper, Kansas 67508 Application Number:

3 LOCATE WELL'S LOCATION WITH AN "X" IN SECTION BOX:

 4 DEPTH OF COMPLETED WELL: 94' ft. ELEVATION:
 Depth(s) Groundwater Encountered 1. 61' ft. 2. ft. 3. ft.
 WELL'S STATIC WATER LEVEL 61' ft. below land surface measured on mo/day/yr Mar. 15 -96
 Pump test data: Well water was ft. after hours pumping gpm
 Est. Yield 20 gpm; Well water was NA ft. after hours pumping gpm
 Bore Hole Diameter 7 7/8" in. to 94' ft. and in. to ft.
 WELL WATER TO BE USED AS: 5 Public water supply 8 Air conditioning 11 Injection well
~~XXX~~ Domestic 3 Feedlot 6 Oil field water supply 9 Dewatering 12 Other (Specify below)
 2 Irrigation 4 Industrial 7 Lawn and garden only 10 Monitoring well
 Was a chemical/bacteriological sample submitted to Department? Yes No ; If yes, mo/day/yr sample was submitted
 Water Well Disinfected? Yes No

5 TYPE OF BLANK CASING USED:
 1 Steel 3 RMP (SR) 6 Asbestos-Cement 9 Other (specify below) Welded
 X 2 PVC 4 ABS 7 Fiberglass Threaded
 Blank casing diameter 5 in. to 60' ft. Dia 5" in. to 70' - 80' ft. Dia in. to ft.
 Casing height above land surface 14" in. weight 160 lbs./ft. Wall thickness or gauge No. SDR 26
 TYPE OF SCREEN OR PERFORATION MATERIAL: XX PVC 10 Asbestos-cement
 1 Steel 3 Stainless steel 5 Fiberglass 8 RMP (SR) 11 Other (specify)
 2 Brass 4 Galvanized steel 6 Concrete tile 9 ABS 12 None used (open hole)
 SCREEN OR PERFORATION OPENINGS ARE:
 1 Continuous slot 3 Mill slot 6 Wire wrapped 9 Drilled holes
 2 Louvered shutter 4 Key punched 7 Torch cut 10 Other (specify)
 SCREEN-PERFORATED INTERVALS: From 60' ft. to 70' ft. From 84' ft. to 94' ft.
 GRAVEL PACK INTERVALS: From 94' ft. to 55' ft. From 50' ft. to 36' ft.

6 GROUT MATERIAL: 1 Neat cement 2 Cement grout XXX Bentonite 4 Other
 Grout Intervals: From 55' ft. to 50' ft. From 36' ft. to 3' ft. From ft. to ft.
 What is the nearest source of possible contamination: XX Livestock pens 14 Abandoned water well
 1 Septic tank 4 Lateral lines 7 Pit privy 11 Fuel storage 15 Oil well/Gas well
 2 Sewer lines 5 Cess pool 8 Sewage lagoon 12 Fertilizer storage 16 Other (specify below)
 3 Watertight sewer lines 6 Seepage pit 9 Feedyard 13 Insecticide storage
 Direction from well? South How many feet? 175'

FROM	TO	LITHOLOGIC LOG	FROM	TO	PLUGGING INTERVALS
0'	2'	Top soil.			
2'	17'	Course Gravel.			
17'	21'	Sand & Clay.			
21'	30'	Medium Course Sand.			
30'	38'	Fine Sand.			
38'	45'	Clay / Sand Strips.			
45'	56'	Course Sand.			
56'	59'	Clay.			
59'	70'	Medium Course Sand. (Very white)			
70'	84'	Clay.			
84'	94'	Medium Course Sand.			
94'		Red Bed			

7 CONTRACTOR'S OR LANDOWNER'S CERTIFICATION: This water well was (1) constructed, (2) reconstructed, or (3) plugged under my jurisdiction and was completed on (mo/day/year) March 12- 1996 and this record is true to the best of my knowledge and belief. Kansas Water Well Contractor's License No. 112 This Water Well Record was completed on (mo/day/year) March 21-1996 under the business name of Wells Drilling Co. by signature Dal Wells