


1 LOCATION OF WATER WELL: Fraction C 1/4 SE 1/4 NW 1/4 Section Number 18 Township Number T 31 S Range Number R 8 **EW**

County: Harper Distance and direction from nearest town or city street address of well if located within city?
7 north, 1 west of Attica, Ks.

2 WATER WELL OWNER: Colt Resources Corp.
RR#, St. Address, Box #: 16701 Green Point Park Drive-# 225 Board of Agriculture, Division of Water Resources
City, State, ZIP Code: Houston, Texas 77060 Application Number: 970060

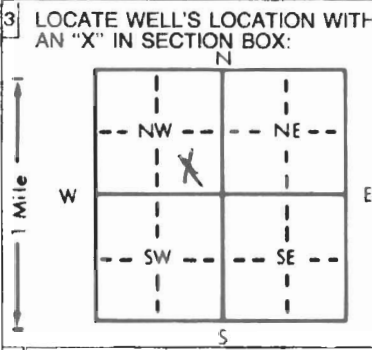

4 DEPTH OF COMPLETED WELL: 80 ft. ELEVATION:
Depth(s) Groundwater Encountered 1. ft. 2. ft. 3. ft.
WELL'S STATIC WATER LEVEL: 36 ft. below land surface measured on mo/day/yr 2-17-97
Pump test data: Well water was _____ ft. after _____ hours pumping _____ gpm
Est. Yield _____ gpm: Well water was _____ ft. after _____ hours pumping _____ gpm
Bore Hole Diameter: 9. 7/8 in. to _____ ft. and _____ in. to _____ ft.
WELL WATER TO BE USED AS:
1 Domestic 3 Feedlot 6 Oil field water supply 9 Dewatering 12 Other (Specify below)
2 Irrigation 4 Industrial 7 Lawn and garden only 10 Monitoring well
Was a chemical/bacteriological sample submitted to Department? Yes _____ No X If yes, mo/day/yr sample was submitted
Water Well Disinfected? Yes hth No

5 TYPE OF BLANK CASING USED:
1 Steel 3 RMP (SR) 5 Wrought iron 8 Concrete tile CASING JOINTS: Glued X Clamped _____
2 PVC 4 ABS 6 Asbestos-Cement 9 Other (specify below) Welded _____
7 Fiberglass Threaded _____
Blank casing diameter: 5 in. to 50 ft. Dia. _____ in. to _____ ft. Dia. _____ in. to _____ ft.
Casing height above land surface: 2' in., weight SDR 26 lbs./ft. Wall thickness or gauge No. _____
TYPE OF SCREEN OR PERFORATION MATERIAL:
1 Steel 3 Stainless steel 5 Fiberglass 7 PVC 10 Asbestos-cement
2 Brass 4 Galvanized steel 6 Concrete tile 8 RMP (SR) 11 Other (specify) _____
9 ABS 12 None used (open hole)
SCREEN OR PERFORATION OPENINGS ARE:
1 Continuous slot 3 Mill slot 5 Gauzed wrapped 8 Saw cut 11 None (open hole)
2 Louvered shutter 4 Key punched 6 Wire wrapped 9 Drilled holes
7 Torch cut 10 Other (specify) _____
SCREEN-PERFORATED INTERVALS: From 80 ft. to 50 ft. From _____ ft. to _____ ft.
GRAVEL PACK INTERVALS: From 80 ft. to 20 ft. From _____ ft. to _____ ft.

6 GROUT MATERIAL: 1 Neat cement 2 Cement grout 3 Bentonite 4 Other hole plug _____
Grout Intervals: From 20 ft. to 0 ft. From _____ ft. to _____ ft. From _____ ft. to _____ ft.
What is the nearest source of possible contamination:
1 Septic tank 4 Lateral lines 7 Pit privy 10 Livestock pens 14 Abandoned water well
2 Sewer lines 5 Cess pool 8 Sewage lagoon 11 Fuel storage 15 Oil well/Gas well
3 Watertight sewer lines 6 Seepage pit 9 Feedyard 12 Fertilizer storage 16 Other (specify below)
13 Insecticide storage

Direction from well? East How many feet? 1000'

FROM	TO	LITHOLOGIC LOG	FROM	TO	PLUGGING INTERVALS
0	3	Top soil			
3	15	Brown clay			
15	28	Brown & gray clay			
28	60	Sand and gravel medium loose			
60	63	Yellow brown clay			
63	73	Sand and gravel			
73	75	Brown & white clay			
75	77	Sand and gravel			
77	80	Redish brown sandy clay			

7 CONTRACTOR'S OR LANDOWNER'S CERTIFICATION: This water well was (1) constructed, (2) reconstructed, or (3) plugged under my jurisdiction and was completed on (mo/day/year) 2-17-97 and this record is true to the best of my knowledge and belief. Kansas Water Well Contractor's License No. 134 This Water Well Record was completed on (mo/day/yr) 2-24-97 under the business name of Rosencrantz-Bemis by (signature) Fredia Rodson

OFFICE USE ONLY
T
R
EW
SEC