


1 LOCATION OF WATER WELL: Fraction SW 1/4 NE 1/4 NW 1/4 Section Number 1 Township Number T 31 S Range Number R 8 EW

Distance and direction from nearest town or city street address of well if located within city?
 45 3/4 E 1/4 S OF SPIVY, KS

2 WATER WELL OWNER: Sweetman Drilling Co.
 RR#, St. Address, Box #: One Main Pl. Suite 410 Board of Agriculture, Division of Water Resources
 City, State, ZIP Code: Wichita, Kansas 67202 McInire B1 Application Number:

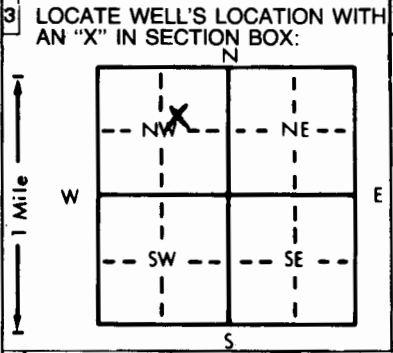

4 DEPTH OF COMPLETED WELL: 100 ft. ELEVATION:
 Depth(s) Groundwater Encountered 1. 65 ft. 2. ft. 3. ft.
 WELL'S STATIC WATER LEVEL 65' ft. below land surface measured on mo/day/yr 20 Nov 81
 Pump test data: Well water was ft. after hours pumping gpm
 Est. Yield 70 gpm: Well water was ft. after hours pumping gpm
 Bore Hole Diameter 10 in. to 100 ft., and in. to ft.
 WELL WATER TO BE USED AS:
 5 Public water supply 8 Air conditioning 11 Injection well
 1 Domestic 3 Feedlot 6 Oil field water supply 9 Dewatering 12 Other (Specify below)
 2 Irrigation 4 Industrial 7 Lawn and garden only 10 Observation well
 Was a chemical/bacteriological sample submitted to Department? Yes No X; If yes, mo/day/yr sample was submitted
 Water Well Disinfected? Yes X No

5 TYPE OF BLANK CASING USED:
 1 Steel 3 RMP (SR) 5 Wrought iron 8 Concrete tile CASING JOINTS: Glued X Clamped
 2 PVC 4 ABS 6 Asbestos-Cement 9 Other (specify below) Welded
 7 Fiberglass Threaded
 Blank casing diameter 5 in. to 60 ft., Dia in. to ft., Dia in. to ft.
 Casing height above land surface 12 in., weight lbs./ft. Wall thickness or gauge No. 214

TYPE OF SCREEN OR PERFORATION MATERIAL:
 1 Steel 3 Stainless steel 5 Fiberglass 8 RMP (SR) 10 Asbestos-cement
 2 Brass 4 Galvanized steel 6 Concrete tile 9 ABS 11 Other (specify)
 12 None used (open hole)

SCREEN OR PERFORATION OPENINGS ARE:
 1 Continuous slot 3 Mill slot 5 Gauzed wrapped 8 Saw cut 11 None (open hole)
 2 Louvered shutter 4 Key punched 6 Wire wrapped 9 Drilled holes
 7 Torch cut 10 Other (specify)

SCREEN-PERFORATED INTERVALS: From 60 ft. to 100 ft., From ft. to ft.
 From ft. to ft., From ft. to ft.
 GRAVEL PACK INTERVALS: From 10 ft. to 100 ft., From ft. to ft.
 From ft. to ft., From ft. to ft.

6 GROUT MATERIAL: 1 Neat cement 2 Cement grout 3 Bentonite 4 Other
 Grout Intervals: From 0 ft. to 10 ft., From ft. to ft., From ft. to ft.

What is the nearest source of possible contamination:
 1 Septic tank 4 Lateral lines 7 Pit privy 10 Livestock pens 14 Abandoned water well
 2 Sewer lines 5 Cess pool 8 Sewage lagoon 11 Fuel storage 15 Oil well/Gas well
 3 Watertight sewer lines 6 Seepage pit 9 Feedyard 12 Fertilizer storage 16 Other (specify below)
 13 Insecticide storage NONE

Direction from well? How many feet?

FROM	TO	LITHOLOGIC LOG	FROM	TO	LITHOLOGIC LOG
0	2	Top soil			
2	5	Clay, dark brown			
5	20	Sand, fine to coarse and fine to med gravel			
20	25	Clay, brown			
25	45	Sand, fine to med and fine gravel			
45	60	Clay, brown and tan			
60	100	Sand, fine to med and fine to med gravel with tan clay streaks			

7 CONTRACTOR'S OR LANDOWNER'S CERTIFICATION: This water well was (1) constructed, (2) reconstructed, or (3) plugged under my jurisdiction and was completed on (mo/day/year) 20 Nov. 81 and this record is true to the best of my knowledge and belief. Kansas Water Well Contractor's License No. 325 This Water Well Record was completed on (mo/day/yr) 10 JUN 82 under the business name of Central Well & Pump Inc. Pratt, Ks. by (signature) [Signature]

INSTRUCTIONS: Use typewriter or ball point pen, PLEASE PRESS FIRMLY and PRINT clearly. Please fill in blanks, underline or circle the correct answers. Send top three copies to Kansas Department of Health and Environment, Division of Environment, Environmental Geology Section, Topeka, KS 66620. Send one to WATER WELL OWNER and retain one for your records.

OFFICE USE ONLY

T

31

R

8

EW

SEC.

SW 1/4 NE 1/4 NW 1/4