


1 LOCATION OF WATER WELL: County: HARPER Fraction: N/2 1/4 N/2 1/4 NE 1/4 Section Number: 10 Township Number: T 31 S Range Number: R 8 E/W

Distance and direction from nearest town or city street address of well if located within city?
5-W 1-S OF DUQUOIN, KS.

2 WATER WELL OWNER: L.D. DRILLING INC.
RR#, St. Address, Box #: R.R. 1 BOX 183-B Board of Agriculture, Division of Water Resources
City, State, ZIP Code: GREAT BEND, KS. 67530 Application Number: 91-0426

3 LOCATE WELL'S LOCATION WITH AN "X" IN SECTION BOX:

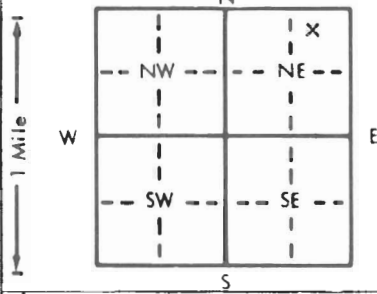

4 DEPTH OF COMPLETED WELL: 103 ft. ELEVATION:
Depth(s) Groundwater Encountered: 1. . ft. 2. . ft. 3. . ft.
WELL'S STATIC WATER LEVEL: 65 ft. below land surface measured on mo/day/yr
Pump test data: Well water was . ft. after . hours pumping . gpm
Est. Yield . gpm: Well water was . ft. after . hours pumping . gpm
Bore Hole Diameter: 9 in. to . ft., and . in. to . ft.
WELL WATER TO BE USED AS: 5 Public water supply 8 Air conditioning 11 Injection well
1 Domestic 3 Feedlot ~~8~~ Oil field water supply 9 Dewatering 12 Other (Specify below)
2 Irrigation 4 Industrial 7 Lawn and garden only 10 Monitoring well
Was a chemical/bacteriological sample submitted to Department? Yes . No .; If yes, mo/day/yr sample was submitted
Water Well Disinfected? Yes No

5 TYPE OF BLANK CASING USED: 1 Steel 3 RMP (SR) 5 Wrought iron 8 Concrete tile CASING JOINTS: Glued Clamped .
 PVC 4 ABS 6 Asbestos-Cement 9 Other (specify below) Welded .
Blank casing diameter: 5 in. to 83 ft., Dia . in. to . ft., Dia . in. to . ft.
Casing height above land surface: 12 in., weight . lbs./ft. Wall thickness or gauge No. .
TYPE OF SCREEN OR PERFORATION MATERIAL: XX7 PVC 10 Asbestos-cement
1 Steel 3 Stainless steel 5 Fiberglass 8 RMP (SR) 11 Other (specify) .
2 Brass 4 Galvanized steel 6 Concrete tile 9 ABS 12 None used (open hole)

SCREEN OR PERFORATION OPENINGS ARE: 5 Gauzed wrapped 8 Saw cut 11 None (open hole)
1 Continuous slot Mill slot 6 Wire wrapped 9 Drilled holes
2 Louvered shutter 4 Key punched 7 Torch cut 10 Other (specify) .

SCREEN-PERFORATED INTERVALS: From . 83 . ft. to . 103 . ft., From . ft. to . ft.
GRAVEL PACK INTERVALS: From . 20 . ft. to . 103 . ft., From . ft. to . ft.

6 GROUT MATERIAL: 1 Neat cement 2 Cement grout Bentonite 4 Other .
Grout Intervals: From . 0 . ft. to . 20 . ft., From . ft. to . ft., From . ft. to . ft.

What is the nearest source of possible contamination:
1 Septic tank 4 Lateral lines 7 Pit privy 10 Livestock pens 14 Abandoned water well
2 Sewer lines 5 Cess pool 8 Sewage lagoon 11 Fuel storage 15 Oil well/Gas well
3 Watertight sewer lines 6 Seepage pit 9 Feedyard 12 Fertilizer storage 16 Other (specify below)
Direction from well? How many feet? NONE

FROM	TO	LITHOLOGIC LOG	FROM	TO	PLUGGING INTERVALS
0	3	TOP SOIL			
3	40	CLAY & GRAVEL			
40	103	GRAVEL			

7 CONTRACTOR'S OR LANDOWNER'S CERTIFICATION: This water well was constructed, (2) reconstructed, or (3) plugged under my jurisdiction and was completed on (mo/day/year) 9-25-91 and this record is true to the best of my knowledge and belief. Kansas Water Well Contractor's License No. 462-B This Water Well Record was completed on (mo/day/yr) 10-1-91 under the business name of SAM'S WATER WELL SERVICE by (signature) Sara Graham