


WATER WELL RECORD Form WWC-5 KSA 82a-1212

1 LOCATION OF WATER WELL:	Fraction	Section Number	Township Number	Range Number
County: <u>HARPER</u>	<u>NE</u> $\frac{1}{4}$ <u>NW</u> $\frac{1}{4}$ <u>NE</u> $\frac{1}{4}$	<u>18</u>	<u>T 31 S</u>	<u>R 8 E/W</u>

Distance and direction from nearest town or city street address of well if located within city?
8-W 2-S OF DUQUOIM, KS.

2 WATER WELL OWNER: VAL ENERGY INC. RR#, St. Address, Box # : <u>P.O. BOX 322</u> City, State, ZIP Code : <u>HAYSVILLE, KS. 67060-0322</u>	Board of Agriculture, Division of Water Resources Application Number: <u>93-0225</u>
---	---

3 LOCATE WELL'S LOCATION WITH AN "X" IN SECTION BOX:

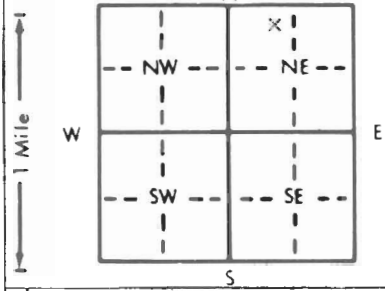

4 DEPTH OF COMPLETED WELL: 84 ft. ELEVATION:

Depth(s) Groundwater Encountered 1. ft. 2. ft. 3. ft.

WELL'S STATIC WATER LEVEL 38 ft. below land surface measured on mo/day/yr

Pump test data: Well water was ft. after hours pumping gpm

Est. Yield gpm: Well water was ft. after hours pumping gpm

Bore Hole Diameter 5 in. to ft., and in. to ft.

WELL WATER TO BE USED AS:

1 Domestic	2 Irrigation	3 Feedlot	4 Industrial	5 Public water supply	6 Oil field water supply	7 Lawn and garden only	8 Air conditioning	9 Dewatering	10 Monitoring well	11 Injection well	12 Other (Specify below)
				<u>5</u>	<u>6</u>						

Was a chemical/bacteriological sample submitted to Department? Yes.....No.....
 If yes, mo/day/yr sample was submitted Water Well Disinfected? Yes No

5 TYPE OF BLANK CASING USED:

1 Steel	2 RMP (SR)	3 Wrought iron	4 Concrete tile	5 CASING JOINTS: Glued	6 Clamped
<u>X</u> PVC	4 ABS	6 Asbestos-Cement	7 Other (specify below)	7 Welded	
		7 Fiberglass		8 Threaded	

Blank casing diameter 5 in. to 74 ft., Dia in. to ft., Dia in. to ft.

Casing height above land surface 12 in., weight lbs./ft. Wall thickness or gauge No.

TYPE OF SCREEN OR PERFORATION MATERIAL:

1 Steel	2 Stainless steel	3 Fiberglass	4 RMP (SR)	5 10 Asbestos-cement
2 Brass	4 Galvanized steel	6 Concrete tile	9 ABS	11 Other (specify)
				12 None used (open hole)

SCREEN OR PERFORATION OPENINGS ARE:

1 Continuous slot	2 Mill slot	3 Gauzed wrapped	4 Saw cut	5 11 None (open hole)
2 Louvered shutter	4 Key punched	6 Wire wrapped	9 Drilled holes	
		7 Torch cut	10 Other (specify)	

SCREEN-PERFORATED INTERVALS: From 76 ft. to 84 ft., From ft. to ft.

GRAVEL PACK INTERVALS: From 20 ft. to 84 ft., From ft. to ft.

6 GROUT MATERIAL:

1 Neat cement	2 Cement grout	3 Bentonite	4 Other
---------------	----------------	-------------	---------

Grout Intervals: From 0 ft. to 20 ft., From ft. to ft., From ft. to ft.

What is the nearest source of possible contamination:

1 Septic tank	2 Lateral lines	3 Pit privy	4 Livestock pens	5 Abandoned water well
2 Sewer lines	5 Cess pool	8 Sewage lagoon	11 Fuel storage	15 Oil well/Gas well
3 Watertight sewer lines	6 Seepage pit	9 Feedyard	12 Fertilizer storage	16 Other (specify below)
			13 Insecticide storage	<u>NONE</u>

Direction from well? How many feet?

FROM	TO	LITHOLOGIC LOG	FROM	TO	PLUGGING INTERVALS
0	3	<u>7</u> TOP SOIL			
3	40	CLAY			
40	84	GRAVEL			

7 CONTRACTOR'S OR LANDOWNER'S CERTIFICATION: This water well was X constructed, (2) reconstructed, or (3) plugged under my jurisdiction and was completed on (mo/day/year) JULY 5, 1993 and this record is true to the best of my knowledge and belief. Kansas Water Well Contractor's License No. 462-B This Water Well Record was completed on (mo/day/year) OCT. 13, 1993 under the business name of SAM'S WATER WELL SERVICE by (signature) Sara Ruffern

INSTRUCTIONS Use typewriter or ball point pen. PLEASE PRESS FIRMLY and PRINT clearly Please fill in blanks, underline or circle the correct answers. Send top three copies to Kansas Department of Health and Environment, Bureau of Water, Topeka, Kansas 66620-0001. Telephone: 913-296-5545. Send one to WATER WELL OWNER and retain one for your records.