


1 LOCATION OF WATER WELL: Fraction NE/4 Section Number 2 Township Number 31 S Range Number 8
 County: Harper

Distance and direction from nearest town or city street address of well if located within city?
4 1/2 miles southeast of Spivey KS

2 WATER WELL OWNER: MTM Petroleum, Inc.
 RR #, St. Address, Box #: P.O. Box 82
 City, State, ZIP Code: Spivey KS 67142
 Board of Agriculture, Division of Water Resources Application Number: 20050022

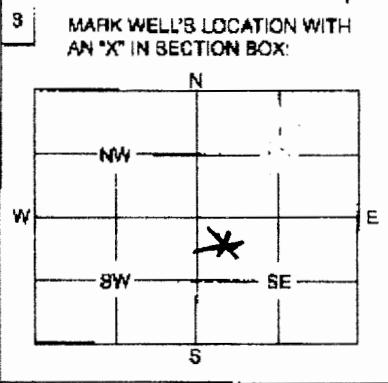

4 DEPTH OF WELL 118 ft.
 WELL'S STATIC WATER LEVEL 80 ft.
 WELL WAS USED AS:
 1 Domestic 2 Irrigation 3 Feedlot 4 Industrial 5 Public Water Supply 6 Dil Field Water Supply 7 Domestic (Lawn & Garden) 8 Air Conditioning 9 Dewatering 10 Monitoring Well 11 Injection Well 12 Other
 Was a chemical / bacteriological sample submitted to Department? Yes No X
 If yes, mo/day/yr sample was submitted
 Water Well Disinfected: Yes X No

5 TYPE OF BLANK CASING USED:
 1 Steel 2 PVC 3 RMP (SR) 4 ABS 5 Wrought 6 Asbestos-Cement 7 Fiberglass 8 Concrete Tile 9 Other (Specify below)
 Blank casing diameter 5" in. Was casing pulled? Yes No X If yes, how much
 Casing height above or below land surface below - 56" in.

6 GROUT PLUG MATERIAL: 1 Neat cement 2 Cement grout 3 Bentonite 4 Other Sand
 Grout Plug Intervals: From 0 ft. to 4 ft., From 4 ft. to 80 ft., From 80 to 110 ft.
 What is the nearest source of possible contamination:
 1 Septic tank 2 Sewer lines 3 Watertight sewer lines 4 Lateral lines 5 Cess pool 6 Seepage pit 7 Pit privy 8 Sewage lagoon 9 Feedyard 10 Livestock pens 11 Fuel storage 12 Fertilizer storage 13 Insecticide storage 14 Abandoned water well 15 Oil well/Gas well 16 Other (specify below)
 Direction from well? How many feet?

FROM	TO	PLUGGING MATERIALS
80	110	Sand
4	80	Bentonite
0	4	Neat Cement

RECEIVED
 OCT 26 2005
 BUREAU OF WATER

7 CONTRACTOR'S OR LANDOWNER'S CERTIFICATION: This water well was plugged under my jurisdiction and was completed on (mo/day/year) October 13, 2005 and this record is true to the best of my knowledge and belief. Kansas Water Well Contractor's License No. 1236 This Water Well Record was completed on (mo/day/year) October 21, 2005 under the business name of MTM Petroleum, Inc. by (signature) Kathy Hill

INSTRUCTIONS: Use typewriter or ball point pen. Please press firmly and print clearly. Please fill in blanks, underline or circle the correct answers. Send top three copies to Kansas Department of Health and Environment, Bureau of Water, Geology Section, 1000 SW Jackson St., Ste. 420, Topeka, Kansas 66612-1367. Telephone: 785/296-5522. Send one to Water Well Owner and retain one for your records.