


1 LOCATION OF WATER WELL: Fraction NE 1/4 NE 1/4 SW 1/4 Section Number 8 Township Number T 31 S Range Number R 9 EW

Distance and direction from nearest town or city street address of well if located within city?
 5S 2 1/2 W 1/2 S OF ZENDA, KS

2 WATER WELL OWNER: Sweetman Drilling Company
 RR#, St. Address, Box #: One Main Place Suite 410
 City, State, ZIP Code: Wichita, Kansas 67202
 DAVIS A1 Board of Agriculture, Division of Water Resources
 Application Number:

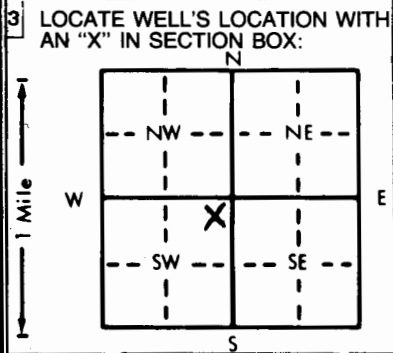

4 DEPTH OF COMPLETED WELL: 145 ft. ELEVATION:
 Depth(s) Groundwater Encountered 1. 93 ft. 2. ft. 3. ft.
 WELL'S STATIC WATER LEVEL 93 ft. below land surface measured on mo/day/yr 12 Oct. 82
 Pump test data: Well water was ft. after hours pumping gpm
 Est. Yield 60 gpm: Well water was ft. after hours pumping gpm
 Bore Hole Diameter 10 in. to 145 ft. and in. to ft.
 WELL WATER TO BE USED AS:
 5 Public water supply 8 Air conditioning 11 Injection well
 1 Domestic 3 Feedlot (8) Oil field water supply 9 Dewatering 12 Other (Specify below)
 2 Irrigation 4 Industrial 7 Lawn and garden only 10 Observation well
 Was a chemical/bacteriological sample submitted to Department? Yes No (X); If yes, mo/day/yr sample was submitted
 Water Well Disinfected? Yes (X) No

5 TYPE OF BLANK CASING USED:
 1 Steel 3 RMP (SR) 5 Wrought iron 8 Concrete tile CASING JOINTS: Glued (X) Clamped
 (2) PVC 4 ABS 6 Asbestos-Cement 9 Other (specify below) Welded
 7 Fiberglass Threaded
 Blank casing diameter 5 in. to 90 ft. Dia in. to ft. Dia in. to ft.
 Casing height above land surface 12 in., weight lbs./ft. Wall thickness or gauge No. 214
 TYPE OF SCREEN OR PERFORATION MATERIAL:
 1 Steel 3 Stainless steel 5 Fiberglass 8 RMP (SR) 10 Asbestos-cement
 2 Brass 4 Galvanized steel 6 Concrete tile 9 ABS 11 Other (specify)
 12 None used (open hole)
 SCREEN OR PERFORATION OPENINGS ARE:
 1 Continuous slot 3 Mill slot 5 Gauzed wrapped (8) Saw cut 11 None (open hole)
 2 Louvered shutter 4 Key punched 6 Wire wrapped 9 Drilled holes
 7 Torch cut 10 Other (specify)
 SCREEN-PERFORATED INTERVALS: From 90 ft. to 102 ft. From 137 ft. to 145 ft.
 From ft. to ft. From ft. to ft.
 GRAVEL PACK INTERVALS: From 10 ft. to 145 ft. From ft. to ft.
 From ft. to ft. From ft. to ft.

6 GROUT MATERIAL: 1 Neat cement (2) Cement grout 3 Bentonite 4 Other
 Grout Intervals: From 0 ft. to 10 ft. From ft. to ft. From ft. to ft.
 What is the nearest source of possible contamination:
 1 Septic tank 4 Lateral lines 7 Pit privy 10 Livestock pens 14 Abandoned water well
 2 Sewer lines 5 Cess pool 8 Sewage lagoon 11 Fuel storage 15 Oil well/Gas well
 3 Watertight sewer lines 6 Seepage pit 9 Feedyard 12 Fertilizer storage 16 Other (specify below)
 13 Insecticide storage NONE

Direction from well? How many feet?

FROM	TO	LITHOLOGIC LOG	FROM	TO	LITHOLOGIC LOG
0	2	Top soil			
2	8	Clay, tan			
8	26	Sand, fine to coarse and fine to coarse gravel			
26	50	Clay, gray and tan			
50	60	Sand, fine to coarse and fine gravel			
60	90	Clay, gray and blue			
90	100	Sand, fine to coarse and fine gravel			
100	139	Clay, white and gray			
139	145	Sand, fine to coarse and fine gravel			

7 CONTRACTOR'S OR LANDOWNER'S CERTIFICATION: This water well was (1) constructed, (2) reconstructed, or (3) plugged under my jurisdiction and was completed on (mo/day/year) 12 OCT 82 and this record is true to the best of my knowledge and belief. Kansas Water Well Contractor's License No. 325 This Water Well Record was completed on (mo/day/yr) 9 JUN 83 under the business name of Central Well & Pump Inc, by (signature) S. St. Anomich

INSTRUCTIONS: Use typewriter or ball point pen, PLEASE PRESS FIRMLY and PRINT clearly. Please fill in blanks, underline or circle the correct answers. Send top three copies to Kansas Department of Health and Environment, Division of Environment, Environmental Geology Section, Topeka, KS 66620. Send one to WATER WELL OWNER and retain one for your records.

OFFICE USE ONLY T 31 R 9 EW SEC. 8 NE 1/4 SE 1/4 SW 1/4