

USE TYPEWRITER OR BALL POINT PEN-PRESS FIRMLY, PRINT CLEARLY.

T R EW sec 1/4 1/4 1/4 No.


WATER WELL RECORD
KSA 82a-1201-1215

Kansas State Dept. Of Health
(Water Well Contractors)
Forbes-Bldg. 740
Topeka, Kansas 66620

Ellis Beach #1 Mine

1 Location of well: County Harper Township name _____ Fraction SESE Section number 12 Town number 315 Range number 9W

Distance and direction from nearest town or city: 7 S
Street address of well location if in city: Zenda, Kan
3 Owner of well: Red Tiger Drilling Co
Address: 1720 Wichita Plaza
Wichita, Kans

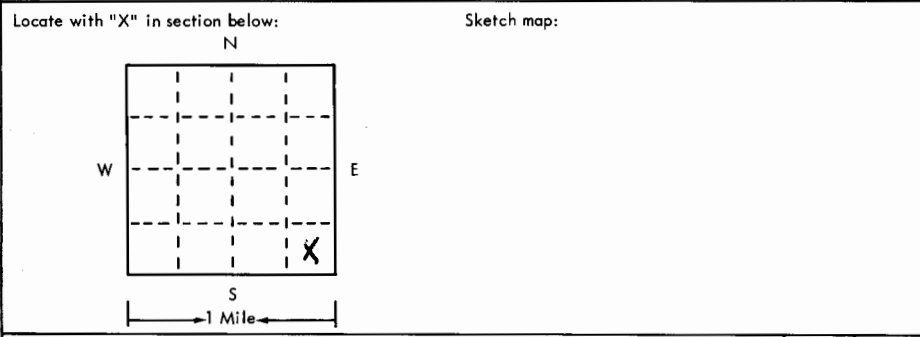

4 Well depth: 110 ft. Date of completion 4-1-75
Well diameter 7 in.
5 Cable tool Rotary Driven Dug
 Hollow rod Jetted Bored Reverse rotary
6 Use: Domestic Public supply Industry
 Irrigation Air conditioning Commercial
 Test well Oil Rig Supply
7 Casing: Material PVC Height: above/below
Threaded Welded Surface 12 in.
Diam. _____ Weight _____ lbs./ft. _____
4 in. to 110 ft. depth Drive shoe? Yes No
_____ in. to _____ ft. depth

2	Type and color of material	From	To
	Top Soil - Clay	0	30
	Sandy - Clay	30	45
	Sand	45	60
	Sand - Gravel	60	80
	Red Bed	80	110
This Water Well was plugged and abandoned by Red Tiger DRLG Company, Robert A Ganser written com. received 5/27/75 5/28/75 DUB			
(use a second sheet if needed)			

8 Screen: Manufacturer MPI
Type PVC Dia. 4"
Slot/gauze 1/16 Length 20'
Set between 60 ft. and 80 ft.
Fittings: _____
Gravel pack Yes No Size range of material 1/8" - 3/4"
9 Static water level: 45 ft. below land surface Date 4-1-75
10 Pumping level below land surfaces:
_____ ft. after _____ hrs. pumping _____ g.p.m.
_____ ft. after _____ hrs. pumping _____ g.p.m.
Estimated maximum yield 30 g.p.m.
11 Water sample submitted:
 Yes No Date _____
12 Well head completion:
 Pitless adapter Inches above grade 12
13 Well grouted? Yes No
 Neat cement Bentonite _____
Depth: From _____ ft. to _____ ft.
14 Nearest source of possible contamination: Oil
ft. 100 Direction SW Type TEST
Well disinfected upon completion? Yes No
15 Pump: Not installed
Manufacturer's name _____
Model number _____ HP _____ Volts _____
Length of drop pipe _____ ft. capacity _____ g.m.p.
Type:
 Submersible Turbine
 Jet Reciprocating
 Centrifugal Other

16 Remarks: elevation

Topography:
 Hill
 Slope
 Upland
 Valley

17 Water well contractor's certification:
This well was drilled under my jurisdiction and this report is true to the best of my knowledge and belief.
Kelly's Water Well Serv 186
Business name _____ License No. _____
Address RZ & Great Bend KS
Signed Kelly Price Date 4-10-75
Authorized representative