


1] LOCATION OF WATER WELL: County: Harper Fraction: SE 1/4 NE 1/4 NW 1/4 Section Number: 22 Township Number: T 31 S Range Number: R 9 EW

Distance and direction from nearest town or city street address of well if located within city? 7 Mi. So + 1/2 W. Zenda Muir No. 4

2] WATER WELL OWNER: RR#, St. Address, Box #: Edmiston Board of Agriculture, Division of Water Resources City, State, ZIP Code: Application Number:

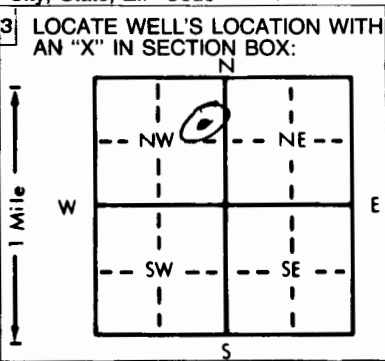

4] DEPTH OF COMPLETED WELL: 120' ft. ELEVATION: Depth(s) Groundwater Encountered 1. 50' ft. 2. ft. 3. ft. WELL'S STATIC WATER LEVEL: 50' ft. below land surface measured on mo/day/yr 10-17-81 Pump test data: Well water was 50' ft. after 24 hours pumping 100 gpm Est. Yield gpm: Well water was ft. after hours pumping gpm Bore Hole Diameter: 7 7/8 in. to 120' ft., and in. to ft. WELL WATER TO BE USED AS: 5 Public water supply 8 Air conditioning 11 Injection well 1 Domestic 3 Feedlot Oil field water supply 9 Dewatering 12 Other (Specify below) 2 Irrigation 4 Industrial 7 Lawn and garden only 10 Observation well Was a chemical/bacteriological sample submitted to Department? Yes No ; If yes, mo/day/yr sample was submitted Water Well Disinfected? Yes No

5] TYPE OF BLANK CASING USED: 1 Steel PVC 3 RMP (SR) 4 ABS 5 Wrought iron 6 Asbestos-Cement 7 Fiberglass 8 Concrete tile 9 Other (specify below) CASING JOINTS: Glued Clamped Welded Threaded Blank casing diameter 5" in. to 100' ft., Dia in. to ft., Dia in. to ft. Casing height above land surface 18" in., weight lbs./ft. Wall thickness or gauge No. TYPE OF SCREEN OR PERFORATION MATERIAL: 1 Steel 2 Brass 3 Stainless steel 4 Galvanized steel 5 Fiberglass 6 Concrete tile 8 RMP (SR) 9 ABS 10 Asbestos-cement 11 Other (specify) 12 None used (open hole) SCREEN OR PERFORATION OPENINGS ARE: 1 Continuous slot 2 Louvered shutter 3 Mill slot 4 Key punched 5 Gauzed wrapped 6 Wire wrapped 7 Torch cut Saw cut 9 Drilled holes 11 None (open hole) SCREEN-PERFORATED INTERVALS: From 100' ft. to 120' ft., From ft. to ft. GRAVEL PACK INTERVALS: From 120' ft. to 40' ft., From ft. to ft.

6] GROUT MATERIAL: Neat cement 2 Cement grout 3 Bentonite 4 Other Grout Intervals: From 120' ft. to 10' ft., From ft. to ft., From ft. to ft. What is the nearest source of possible contamination: 1 Septic tank 2 Sewer lines 3 Watertight sewer lines 4 Lateral lines 5 Cess pool 6 Seepage pit 7 Pit privy 8 Sewage lagoon 9 Feedyard 10 Livestock pens 11 Fuel storage 12 Fertilizer storage 13 Insecticide storage 14 Abandoned water well Oil well/Gas well 16 Other (specify below) Direction from well? How many feet? 60'

FROM	TO	LITHOLOGIC LOG	FROM	TO	LITHOLOGIC LOG

7] CONTRACTOR'S OR LANDOWNER'S CERTIFICATION: This water well was (1) constructed, (2) reconstructed, or plugged under my jurisdiction and was completed on (mo/day/year) 6-30-82 and this record is true to the best of my knowledge and belief. Kansas Water Well Contractor's License No. NONE This Water Well Record was completed on (mo/day/yr) 6-7-84 under the business name of Graves Drilling Co., Wichita, KS by (signature) Clyde R. Kuhn

INSTRUCTIONS: Use typewriter or ball point pen, PLEASE PRESS FIRMLY and PRINT clearly. Please fill in blanks, underline or circle the correct answers. Send top three copies to Kansas Department of Health and Environment, Division of Environment, Environmental Geology Section, Topeka, KS 66620. Send one to WATER WELL OWNER and retain one for your records.

OFFICE USE ONLY