


1 LOCATION OF WATER WELL: County: Harper	Fraction C SW 1/4 1/4 SW 1/4	Section Number 23	Township Number T 31 S	Range Number R 9W E/W
--	--	-----------------------------	----------------------------------	---------------------------------

Distance and direction from nearest town or city street address of well if located within city?
7 1/2 S of Zenda, Kansas

2 WATER WELL OWNER: R. I. Martin RR#, St. Address, Box #: Penolsa, Ks. 67121 City, State, ZIP Code: 67121	Mobil Oil 6031 W 10th Great Bend, Kansas 67530	Martin B-6 Board of Agriculture, Division of Water Resources Application Number: T85-850
--	---	--

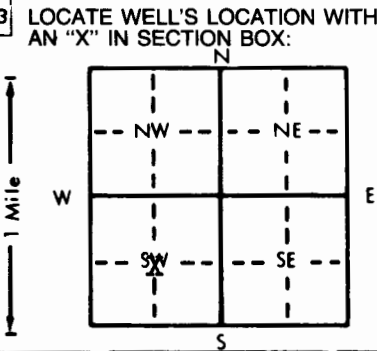

4 DEPTH OF COMPLETED WELL: 70 ft. ELEVATION: Unknown	Depth(s) Groundwater Encountered 1. 30 ft. 2. _____ ft. 3. _____ ft.
WELL'S STATIC WATER LEVEL: 30 ft. below land surface measured on mo/day/yr 9/19/85	
Pump test data: Well water was _____ ft. after _____ hours pumping _____ gpm	
Est. Yield 60 gpm: Well water was _____ ft. after _____ hours pumping _____ gpm	
Bore Hole Diameter: 8 in. to 70 ft., and _____ in. to _____ ft.	
WELL WATER TO BE USED AS: 1 Domestic 3 Feedlot 6 Oil field water supply 9 Dewatering 12 Other (Specify below) 2 Irrigation 4 Industrial 7 Lawn and garden only 10 Observation well	
Was a chemical/bacteriological sample submitted to Department? Yes _____ No <u>_____</u> ; If yes, mo/day/yr sample was submitted _____	
Water Well Disinfected? Yes _____ No <u>_____</u>	

5 TYPE OF BLANK CASING USED: 1 Steel 3 RMP (SR) 5 Wrought iron <u>2 PVC</u> 4 ABS 6 Asbestos-Cement 7 Fiberglass	8 Concrete tile CASING JOINTS: <u>Glued</u> Clamped _____ 9 Other (specify below) Welded _____ Threaded _____
Blank casing diameter: 5 in. to 50 ft., Dia _____ in. to _____ ft., Dia _____ in. to _____ ft.	
Casing height above land surface: 12 in., weight 2.8 lbs./ft. Wall thickness or gauge No. Sch. 40	
TYPE OF SCREEN OR PERFORATION MATERIAL: 1 Steel 3 Stainless steel 5 Fiberglass 8 RMP (SR) 10 Asbestos-cement 2 Brass 4 Galvanized steel 6 Concrete tile 9 ABS 11 Other (specify) _____ 12 None used (open hole)	
SCREEN OR PERFORATION OPENINGS ARE: 1 Continuous slot 3 Mill slot 5 Gauzed wrapped 8 <u>Saw cut</u> 11 None (open hole) 2 Louvered shutter 4 Key punched 6 Wire wrapped 9 Drilled holes 7 Torch cut 10 Other (specify) _____	
SCREEN-PERFORATED INTERVALS: From _____ ft. to _____ ft., From _____ ft. to _____ ft.	
GRAVEL PACK INTERVALS: From _____ ft. to _____ ft., From _____ ft. to _____ ft.	

6 GROUT MATERIAL: 1 Neat cement 2 Cement grout 3 Bentonite 4 Other _____	Grout Intervals: From 0 ft. to 10 ft., From _____ ft. to _____ ft., From _____ ft. to _____ ft.
What is the nearest source of possible contamination: 1 Septic tank 4 Lateral lines 7 Pit privy 10 Livestock pens 14 Abandoned water well 2 Sewer lines 5 Cess pool 8 Sewage lagoon 11 Fuel storage 15 <u>Oil well/Gas well</u> 3 Watertight sewer lines 6 Seepage pit 9 Feedyard 12 Fertilizer storage 16 Other (specify below) _____ 13 Insecticide storage _____	
Direction from well? South How many feet? 60	

FROM	TO	LITHOLOGIC LOG	FROM	TO	LITHOLOGIC LOG
0	25	Clay			
25	65	Sand and Gravel			
65	70	Red Bed			

7 CONTRACTOR'S OR LANDOWNER'S CERTIFICATION: This water well was (1) constructed, (2) reconstructed, or (3) plugged under my jurisdiction and was completed on (mo/day/year) **9/19/85** and this record is true to the best of my knowledge and belief. Kansas Water Well Contractor's License No. **186** This Water Well Record was completed on (mo/day/yr) **10/31/85** under the business name of **Kelly's Water Well Service** by (signature) *[Signature]*

INSTRUCTIONS: Use typewriter or ball point pen, **PLEASE PRESS FIRMLY** and **PRINT** clearly. Please fill in blanks, underline or circle the correct answers. Send top three copies to Kansas Department of Health and Environment, Division of Environment, Environmental Geology Section, Topeka, KS 66620. Send one to WATER WELL OWNER and retain one for your records.