


1 LOCATION OF WATER WELL: County: **SUMNER** Fraction: **NE 1/4 NE 1/4 SW 1/4** Section Number: **23** Township Number: **T 32 S** Range Number: **R 1 E 10**

Distance and direction from nearest town or city street address of well if located within city?  
**206 E. Botkin, Wellington**

2 WATER WELL OWNER: **Sumner Co.** Board of Agriculture, Division of Water Resources  
 RR#, St. Address, Box #: **206 E. Botkin**  
 City, State, ZIP Code: **Wellington, KS 67152** Application Number:

3 LOCATE WELL'S LOCATION WITH AN "X" IN SECTION BOX: 4 DEPTH OF COMPLETED WELL: **17** ft. ELEVATION: **1181.98**

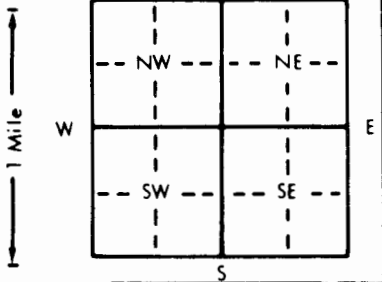

Depth(s) Groundwater Encountered 1. **5** ft. 2. . . . . ft. 3. . . . . ft.  
 WELL'S STATIC WATER LEVEL ~~177.45~~ **1.53** ft. below land surface measured on mo/day/yr **7-13-95**  
 Pump test data: Well water was **N/A** ft. after . . . . . hours pumping . . . . . gpm  
 Est. Yield . . . . . gpm: Well water was . . . . . ft. after . . . . . hours pumping . . . . . gpm  
 Bore Hole Diameter: **8** in. to **17** ft., and . . . . . in. to . . . . . ft.  
 WELL WATER TO BE USED AS:  
 1 Domestic 3 Feedlot 6 Oil field water supply 9 Dewatering 12 Other (Specify below)  
 2 Irrigation 4 Industrial 7 Lawn and garden only  Monitoring well **AMW-5**  
 Was a chemical/bacteriological sample submitted to Department? Yes . . . . . No  If yes, mo/day/yr sample was submitted  
 Water Well Disinfected? Yes  No

5 TYPE OF BLANK CASING USED:  
 1 Steel 3 RMP (SR) 5 Wrought iron 8 Concrete tile CASING JOINTS: Glued . . . . . Clamped . . . . .  
 2 PVC 4 ABS 6 Asbestos-Cement 9 Other (specify below) Welded . . . . .  
 Blank casing diameter **2** in. to **7** ft., Dia . . . . . in. to . . . . . ft., Dia . . . . . in. to . . . . . ft.  
 Casing height above land surface **Flush** in., weight . . . . . lbs./ft. Wall thickness or gauge No. **40**  
 TYPE OF SCREEN OR PERFORATION MATERIAL:  
 1 Steel 3 Stainless steel 5 Fiberglass 8 RMP (SR) 10 Asbestos-cement  
 2 Brass 4 Galvanized steel 6 Concrete tile 9 ABS 12 None used (open hole)

SCREEN OR PERFORATION OPENINGS ARE:  
 1 Continuous slot  3 Mill slot 5 Gauzed wrapped 8 Saw cut 11 None (open hole)  
 2 Louvered shutter 4 Key punched 6 Wire wrapped 9 Drilled holes  
 SCREEN-PERFORATED INTERVALS: From **7** ft. to **17** ft., From . . . . . ft. to . . . . . ft.  
 From . . . . . ft. to . . . . . ft., From . . . . . ft. to . . . . . ft.  
 GRAVEL PACK INTERVALS: From **5** ft. to **17** ft., From . . . . . ft. to . . . . . ft.  
 From . . . . . ft. to . . . . . ft., From . . . . . ft. to . . . . . ft.

6 GROUT MATERIAL: 1 Neat cement 2 Cement grout 3 Bentonite 4 Other  
 Grout Intervals: From **1** ft. to **5** ft., From . . . . . ft. to . . . . . ft., From . . . . . ft. to . . . . . ft.  
 What is the nearest source of possible contamination:  
 1 Septic tank 4 Lateral lines 7 Pit privy  10 Livestock pens 14 Abandoned water well  
 2 Sewer lines 5 Cess pool 8 Sewage lagoon  12 Fertilizer storage 15 Oil well/Gas well  
 3 Watertight sewer lines 6 Seepage pit 9 Feedyard 13 Insecticide storage 16 Other (specify below)  
 Direction from well? **N** How many feet? **210**

FROM	TO	LITHOLOGIC LOG	FROM	TO	PLUGGING INTERVALS
0	8	Silty Clay			
8	11	Clay			
11	17	Sand w/ gravel + clay; tr silt			

7 CONTRACTOR'S OR LANDOWNER'S CERTIFICATION: This water well was  constructed,  reconstructed, or  plugged under my jurisdiction and was completed on (mo/day/year) **2-21-95** and this record is true to the best of my knowledge and belief. Kansas Water Well Contractor's License No. **571** This Water Well Record was completed on (mo/day/yr) **11-2-95** under the business name of **BDAT** by (signature) **Fog**