


1 LOCATION OF WATER WELL: County: **SUMNER** Fraction: **NE 1/4 NE 1/4 SW 1/4** Section Number: **23** Township Number: **T 32 S** Range Number: **R 1 EW**

Distance and direction from nearest town or city street address of well if located within city?  
**206 E. Botkin, Wellington**

2 WATER WELL OWNER: **Sumner Co. Road + Bridge**  
 RR#, St. Address, Box #: **206 E. Botkin**  
 City, State, ZIP Code: **Wellington, KS 67152**  
 Board of Agriculture, Division of Water Resources  
 Application Number:

3 LOCATE WELL'S LOCATION WITH AN "X" IN SECTION BOX:

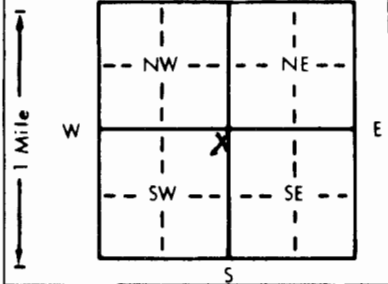

4 DEPTH OF COMPLETED WELL: **17** ft. ELEVATION: **1184.22**

Depth(s) Groundwater Encountered 1. **7** ft. 2. ft. 3. ft.  
 WELL'S STATIC WATER LEVEL: ~~1177.7~~ **6.52** below land surface measured on mo/day/yr **7/13/95**  
 Pump test data: Well water was **NA** ft. after hours pumping gpm  
 Est. Yield **NA** gpm: Well water was ft. after hours pumping gpm  
 Bore Hole Diameter: **8** in. to **17** ft., and in. to ft.  
 WELL WATER TO BE USED AS:  
 5 Public water supply 8 Air conditioning 11 Injection well  
 1 Domestic 3 Feedlot 6 Oil field water supply 9 Dewatering 12 Other (Specify below)  
 2 Irrigation 4 Industrial 7 Lawn and garden only **10 Monitoring well AMW-1**  
 Was a chemical/bacteriological sample submitted to Department? Yes No **X**; If yes, mo/day/yr sample was submitted  
 Water Well Disinfected? Yes **No**

5 TYPE OF BLANK CASING USED:  
 1 Steel 3 RMP (SR) 6 Asbestos-Cement 9 Other (specify below) Welded  
 2 PVC 4 ABS 7 Fiberglass Threaded **✓**  
 Blank casing diameter: **2** in. to **7** ft. Dia. in. to ft. Dia. in. to ft.  
 Casing height above land surface: **Flush** in., weight lbs./ft. Wall thickness or gauge No. **40**

TYPE OF SCREEN OR PERFORATION MATERIAL:  
 1 Steel 3 Stainless steel 5 Fiberglass **10 PVC** 10 Asbestos-cement  
 2 Brass 4 Galvanized steel 6 Concrete tile 8 RMP (SR) 11 Other (specify)  
 9 ABS 12 None used (open hole)

SCREEN OR PERFORATION OPENINGS ARE:  
 1 Continuous slot **3 Mill slot** 6 Wire wrapped 8 Saw cut 11 None (open hole)  
 2 Louvered shutter 4 Key punched 7 Torch cut 9 Drilled holes 10 Other (specify)

SCREEN-PERFORATED INTERVALS: From **7** ft. to **17** ft. From ft. to ft.  
 From ft. to ft. From ft. to ft.  
 GRAVEL PACK INTERVALS: From **5** ft. to **17** ft. From ft. to ft.  
 From ft. to ft. From ft. to ft.

6 GROUT MATERIAL: 1 Neat cement **2 Cement grout** 3 Bentonite 4 Other  
 Grout Intervals: From **1** ft. to **5** ft., From ft. to ft., From ft. to ft.

What is the nearest source of possible contamination:  
 1 Septic tank 4 Lateral lines 7 Pit privy **11 Fuel storage** 14 Abandoned water well  
 2 Sewer lines 5 Cess pool 8 Sewage lagoon 12 Fertilizer storage 15 Oil well/Gas well  
 3 Watertight sewer lines 6 Seepage pit 9 Feedyard 13 Insecticide storage 16 Other (specify below)  
 Direction from well? **NE** How many feet? **80**

FROM	TO	LITHOLOGIC LOG	FROM	TO	PLUGGING INTERVALS
0	6	Silty Clay			
6	14	Clay			
14	17	Sand w/ Gravel; tr silt + clay			

7 CONTRACTOR'S OR LANDOWNER'S CERTIFICATION: This water well was **(1)** constructed, (2) reconstructed, or (3) plugged under my jurisdiction and was completed on (mo/day/year) **2/21/95** and this record is true to the best of my knowledge and belief. Kansas Water Well Contractor's License No. **571** This Water Well Record was completed on (mo/day/yr) **11/2/95** under the business name of **BDAT Env., Inc** by (signature) **By Ellen**