WATER WELL RECORD Form WWC-5 KSA 82a-1212 ID No. _____

1 LOCATION OF WATER WELL: County: Sumner	Fraction: NE ¼ SE ¼ NE ¼	Section Number: 13	Township Number: T 32 S	Range Number: R 1 (W)

Distance and direction from nearest town or city street address of well if located within city?
See attached map

2 WATER WELL OWNER: BNSF
RR#, St. Address, Box # : 1315 E. 1st St.
City, State, ZIP Code : Wellington KS 67152

Board of Agriculture, Division of Water Resources Application Number:

3 LOCATE WELL'S LOCATION WITH AN "X" IN SECTION BOX:

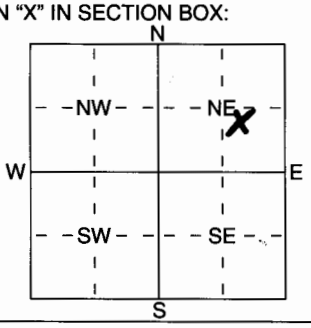

4 DEPTH OF COMPLETED WELL 29.5 ft. ELEVATION: —

Depth(s) Groundwater Encountered 1 21 ft. 2 — ft. 3 — ft.
WELL'S STATIC WATER LEVEL 2.14 ft. below land surface measured on mo/day/yr 5/30/06
Pump test data: Well water was — ft. after — hours pumping — gpm
Est. Yield — gpm: Well water was — ft. after — hours pumping — gpm

WELL WATER TO BE USED AS:
1 Domestic 3 Feedlot 5 Public water supply 6 Oil field water supply 7 Domestic (lawn & garden) 8 Air conditioning 9 Dewatering (10) Monitoring well 11 Injection well 12 Other (Specify below)
2 Irrigation 4 Industrial

Was a chemical/bacteriological sample submitted to Department? Yes ..... No X; If yes, mo/day/yrs sample was submitted
Water Well Disinfected? Yes No X

5 TYPE OF BLANK CASING USED:
1 Steel 3 RMP (SR) 5 Wrought iron 8 Concrete tile
(2) PVC 4 ABS 6 Asbestos-Cement 9 Other (specify below)
7 Fiberglass

CASING JOINTS: Glued ..... Clamped ..... Welded ..... Threaded X

Blank casing diameter 2 in. to 14.5 ft., Dia — in. to — ft., Dia — in. to — ft.
Casing height above land surface 36 in., weight — lbs./ft. Wall thickness or guage No. Sch. 40

TYPE OF SCREEN OR PERFORATION MATERIAL:
1 Steel 3 Stainless Steel 5 Fiberglass (7) PVC 10 Asbestos-Cement
2 Brass 4 Galvanized Steel 6 Concrete tile 8 RMP (SR) 11 Other (Specify) .....
9 ABS 12 None used (open hole)

SCREEN OR PERFORATION OPENINGS ARE:
1 Continuous slot (3) Mill slot 5 Guazed wrapped 8 Saw cut 11 None (open hole)
2 Louvered shutter 4 Key punched 6 Wire wrapped 9 Drilled holes
7 Torch cut 10 Other (specify) ..... ft.

SCREEN-PERFORATED INTERVALS: From 14.5 ft. to 29.5 ft., From — ft. to — ft.
From — ft. to — ft., From — ft. to — ft.
GRAVEL PACK INTERVALS: From 12.5 ft. to 29.5 ft., From — ft. to — ft.
From — ft. to — ft., From — ft. to — ft.

6 GROUT MATERIAL: 1 Neat cement 2 Cement grout (3) Bentonite 4 Other .....
Grout Intervals: From 2 ft. to 12.5 ft., From — ft. to — ft., From — ft. to — ft.

What is the nearest source of possible contamination:
1 Septic tank 4 Lateral lines 7 Pit privy 10 Livestock pens 14 Abandoned water well
2 Sewer lines 5 Cess pool 8 Sewage lagoon 11 Fuel storage 15 Oil well/Gas well
3 Watertight sewer lines 6 Seepage pit 9 Feedyard 12 Fertilizer storage (16) Other (specify below) Landfill
13 Insecticide storage

Direction from well? How many feet?

FROM	TO	LITHOLOGIC LOG	FROM	TO	PLUGGING INTERVALS
		MW-76			
0	18	Silty clay			
18	29	Sand- Fine grading to course			
29	—	Shale			

7 CONTRACTOR'S OR LANDOWNER'S CERTIFICATION: This water well was (1) constructed, (2) reconstructed, or (3) plugged under my jurisdiction and was completed on (mo/day/year) 5.30.06 and this record is true to the best of my knowledge and belief. Kansas Water Well Contractor's Licence No 710 This Water Well Record was completed on (mo/day/yr) 6.5.06 under the business name of Below Ground Surface, Inc. by (signature) [signature]

INSTRUCTIONS: Use typewriter or ball point pen. *PLEASE PRESS FIRMLY* and *PRINT* clearly. Please fill in blanks, underline or circle the correct answers. Send top three copies to Kansas Department of Health and Environment, Bureau of Water, Geology Section, 1000 SW Jackson St., Suite 420, Topeka, Kansas 66612-1367. Telephone 785-296-5522. Send one to WATER WELL OWNER and retain one for your records. Fee of $5.00 for each constructed well.

DELORME

Street Atlas USA® 2004

WELL LOCATION
BNSF SITE
WELLINGTON, KS

ONTARIO ST
HURON CT
ERIE CT
N KIESES ST
N DAY ST
DAY ST
N BOUNDARY RD
160
S KOA DR
N SENECA RD
N BROADWAY RD
S COUNTRYSIDE LN
E 12TH ST S
E 13TH ST S
N GARDNER ST
E 10TH ST
N WOOD LAWN ST
E 7TH ST
S KIESES ST
S FAIR ST
S KEYES ST
STEWART ST
S SHORT ST
S HASLET ST
N PATTERSON ST
Wellington
4TH ST
1ST ST
E 20TH ST S
E 20TH ST
MW-7
MW-7b
S BROADWAY RD
S BOUNDARY RD
S WOOD LAWN ST
S WEST RD
S MERIDIAN RD

© 2003 DeLorme. Street Atlas USA® 2004.
www.delorme.com

TN
MN (4.9°E)

Scale 1 : 25,000
0 800 1200 1600 2400 3000 ft
0 200 400 600 800 1000 m
1" = 2,083.3 ft
Data Zoom 13-0