

WATER WELL RECORD Form WWC-5

Division of Water Resources App. No.

TMW-7

Original Record Correction Change in Well Use

Well ID

1 LOCATION OF WATER WELL: County: Sumner Fraction NE 1/4 NE 1/4 NW 1/4 NW 1/4 Section Number 14 Township Number T 32 S Range Number R 1 E W

2 WELL OWNER: Last Name: Shipe First: Carla Street or Rural Address where well is located (if unknown, distance and direction from nearest town or intersection): If at owner's address, check here: 124 W. 15th St., Wellington, KS

3 LOCATE WELL WITH "X" IN SECTION BOX: N W E S 1 mile

4 DEPTH OF COMPLETED WELL: 16 ft. Depth(s) Groundwater Encountered: 1) ... ft. 2) ... ft. 3) ... ft., or 4) Dry Well WELL'S STATIC WATER LEVEL: 8 ft. below land surface, measured on (mo-day-yr) 7/15/19

5 Latitude: 37.27422 (decimal degrees) Longitude: 97.39958 (decimal degrees) Horizontal Datum: WGS 84 NAD 83 NAD 27 Source for Latitude/Longitude: GPS (unit make/model) (WAAS enabled? Yes No) Land Survey Topographic Map Online Mapper

6 Elevation: 1216.72 ft. Ground Level TOC Source: Land Survey GPS Topographic Map Other

7 WELL WATER TO BE USED AS: 1. Domestic: Household Lawn & Garden Livestock Irrigation Feedlot Industrial 2. Public Water Supply: well ID 3. Dewatering: how many wells? 4. Aquifer Recharge: well ID 5. Monitoring: well ID TMW-7 6. Environmental Remediation: well ID 7. Air Sparge Soil Vapor Extraction Recovery Injection 8. Oil Field Water Supply: lease 9. Test Hole: well ID 10. Geothermal: how many bores? 11. Closed Loop Horizontal Vertical 12. Open Loop Surface Discharge Inj. of Water 13. Other (specify):

Was a chemical/bacteriological sample submitted to KDHE? Yes No If yes, date sample was submitted: Water well disinfected? Yes No

8 TYPE OF CASING USED: Steel PVC Other CASING JOINTS: Glued Clamped Welded Threaded Casing diameter 2 in. to 16 ft., Diameter in. to ft., Diameter in. to ft. Casing height above land surface -0.5 in. Weight lbs./ft. Wall thickness or gauge No. Sch 40 TYPE OF SCREEN OR PERFORATION MATERIAL: Steel Stainless Steel Fiberglass PVC Other (Specify) Brass Galvanized Steel Concrete tile None used (open hole) SCREEN OR PERFORATION OPENINGS ARE: Continuous Slot Mill Slot Gauze Wrapped Torch Cut Drilled Holes Other (Specify) Louvered Shutter Key Punched Wire Wrapped Saw Cut None (Open Hole) SCREEN-PERFORATED INTERVALS: From 6 ft. to 16 ft., From ft. to ft., From ft. to ft. GRAVEL PACK INTERVALS: From 4 ft. to 16 ft., From ft. to ft., From ft. to ft.

9 GROUT MATERIAL: Neat cement Cement grout Bentonite Other Grout Intervals: From 1 ft. to 4 ft., From ft. to ft., From ft. to ft. Nearest source of possible contamination: Septic Tank Lateral Lines Pit Privy Livestock Pens Insecticide Storage Sewer Lines Cess Pool Sewage Lagoon Fuel Storage Abandoned Water Well Watertight Sewer Lines Seepage Pit Feedyard Fertilizer Storage Oil Well/Gas Well Other (Specify) Trust Fund site U2-096-00696 Direction from well? On-site Distance from well? 0 ft.

10 FROM TO LITHOLOGIC LOG FROM TO LITHO. LOG (cont.) or PLUGGING INTERVALS

0	0.5	Concrete			
0.5	8	Silt, clayey, brown			
8	16	Sand, fine grain, grey varing silt			
TD	16				

Notes: Town & Country #12, U2-096-00696

11 CONTRACTOR'S OR LANDOWNER'S CERTIFICATION: This water well was constructed, reconstructed, or plugged under my jurisdiction and was completed on (mo-day-year) 7/15/19 and this record is true to the best of my knowledge and belief. Kansas Water Well Contractor's License No. 585 This Water Well Record was completed on (mo-day-year) 7/31/19 under the business name of Associated Environmental, Inc. Signature

FULL SITE SURVEY



Town & Country #12
City of Wellington, Sumner County, Kansas

Point	North Coordinate	East Coordinate	Distance NW Cor. South	From Sec. 14 East	* Elev. Top of Rim or PK Nail	Elev. Top of PVC Pipe	Latitude North	Longitude West
NW Cor. Sec. 14-T32S-R1W	40000	40000						
Well - T.M.W. - 1	39774.88	41064.84	225.12	1064.84	1217.69	1217.34	37.27427	97.39953
Well - T.M.W. - 2	39789.46	41187.74	210.54	1187.74	1217.39	1217.08	37.27433	97.39911
Well - T.M.W. - 3	39787.40	41130.83	212.60	1130.83	1217.01	1216.66	37.27432	97.39931
Well - T.M.W. - 4	39795.64	41087.86	204.36	1087.86	1217.16	1216.96	37.27433	97.39946
Well - T.M.W. - 5	39710.39	41117.14	289.61	1117.14	1218.20	1217.34	37.27410	97.39935
Well - T.M.W. - 6	39502.04	41070.67	487.96	1070.67	1215.97	1215.73	37.27353	97.39948
Well - T.M.W. - 7	39754.19	41044.66	245.81	1044.66	1217.27	1216.72	37.27422	97.39958
Well - T.M.W. - 8	39698.66	41048.62	301.34	1048.62	1217.27	1216.97	37.27406	97.39958
Well - T.M.W. - 9	39714.88	40986.70	285.12	986.70	1218.37	1217.62	37.27411	97.39981
Well - T.M.W. - 10	39778.36	40991.22	221.64	991.22	1217.54	1216.83	37.27428	97.39979
Well - S.B.1	39714.04	41113.82	285.96	1113.82	1218.2	GND	37.27411	97.39936
Well - S.B.2	39735.02	41110.16	264.98	1110.16	1218.5	GND	37.27417	97.39937
Well - S.B.3	39734.37	41080.55	265.63	1080.55	1218.2	GND	37.27417	97.39947
Well - S.B.4	39761.01	41098.48	238.99	1098.48	1218.1	GND	37.27424	97.39942
Well - S.B.5	39776.05	41103.70	223.95	1103.70	1217.8	GND	37.27428	97.39940
Well - S.B.6	39774.63	41092.04	225.37	1092.04	1217.8	GND	37.27428	97.39944
Well - S.B.7	39767.41	41075.60	232.59	1075.60	1218.0	GND	37.27426	97.39950
Well - S.B.8	39757.93	41083.75	242.07	1083.75	1218.1	GND	37.27465	97.39941
Well - S.B.9	39699.85	41118.84	300.15	1118.84	1218.4	GND	37.27407	97.39938
Well - S.B.10	39700.84	41103.78	299.16	1103.78	1218.3	GND	37.27407	97.39941
Well - S.B.11	39711.69	41116.73	288.31	1116.73	1218.2	GND	37.27412	97.39936
Well - S.B.12	39710.98	41103.50	289.02	1103.50	1217.9	GND	37.27411	97.39938
Well - S.B.13	39720.91	41117.66	279.09	1117.66	1217.8	GND	37.27415	97.39927
Well - S.B.14	39721.33	41107.79	278.67	1107.79	1217.9	GND	37.27414	97.39941
Well - S.B.15	39783.09	41125.00	216.91	1125.00	1216.9	GND	37.27431	97.39936
Well - S.B.16	39782.69	41131.87	217.31	1131.87	1216.8	GND	37.27431	97.39933
Well - S.B.17	39782.87	41138.63	217.13	1138.63	1216.9	GND	37.27431	97.39931
Well - S.B.18	39789.33	41125.48	210.67	1125.48	1217.0	GND	37.27432	97.39934
Well - S.B.19	39789.19	41132.09	210.81	1132.09	1217.0	GND	37.27432	97.39932
Well - S.B.20	39789.09	41138.38	210.91	1138.38	1217.1	GND	37.27433	97.39928
Well - S.B.21	39793.92	41125.04	206.08	1125.04	1216.9	GND	37.27434	97.39933
Well - S.B.22	39793.56	41132.27	206.44	1132.27	1216.8	GND	37.27432	97.39930
Well - S.B.23	39794.67	41137.84	205.33	1137.84	1217.1	GND	37.27431	97.39929
Well - E.C.1	39783.44	41094.99	216.56	1094.99			37.27430	97.39943
Well - E.C.2	39758.08	41079.20	241.92	1079.20			37.27423	97.39948
Well - E.C.3	39775.74	41102.84	224.26	1102.84			37.27428	97.39940
Well - E.C.4	39712.94	41113.36	287.06	1113.36			37.27411	97.39936
Site B.M.	39805.82	41137.41	194.18	1137.41		B.M. Elev. = 1216.47		


Description: " + " cut on northwest corner of curb inlet on south side of West 15th Street.

LEGEND

MW1 ⊙ MONITOR WELL LOCATION	FO □ FIBER OPTIC VAULT	⊙ SANITARY MANHOLE
SB1 ○ GEOPROBE BORING LOCATION	↗ DRAINAGE DIRECTION	+ STREET SIGN
EC1 ▲ EC PROBE LOCATION	oe — OVERHEAD ELECTRIC LINE	WM° WATER METER
⊕ SITE BENCHMARK	ss — SANITARY SEWER LINE	WV° WATER VALVE
⊠ POWER POLE	g — GAS LINE	WS° WATER SPIGOT
PP/T ⊠ POWER POLE W/TRANSFORMER	— WOODEN FENCE LINE	
← DEADMAN ANCHOR	— CENTERLINE TRAVELWAY	
EM° ELECTRIC METER	B/B BACK TO BACK OF CURB	
▼ SPOT LIGHT	E/E EDGE TO EDGE OF ROAD	


 SCALE: 1"=30'


MW3 (194' SOUTH & 129' WEST)

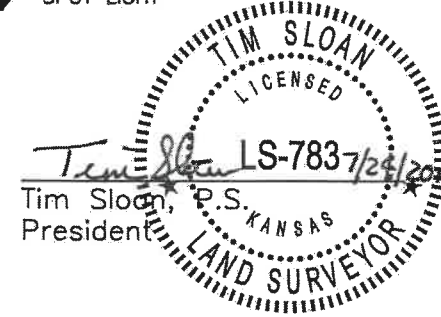

RECEIVED
AUG 19 2019

SMH

CONSULTANTS