
		RECORD		WWC-5	Div	ision of Wat	er			MW10R	
				ge in Well Use		ources App.			Well II		
1 LOCA	TION OF V	WATER WEI	LL:	Fraction		tion Numb	er	Township Numb		ange Number	
	y: Sumner			NE 14 NE 14 NE 14						1 □ E ■ W	
2 WELL OWNER: Last Name: First: Street or Rural Address where well is located (if unknown, distance and											
Business: Sumner County Road & Bridge / Shop Address: 206 E. Botkin Street  direction from nearest town or intersection): If at owner's address, check here:											
Address:											
City: Wellington State: KS ZIP: 67152											
3 LOCAT			LOE CON		20 &	F T 4'4		37 2524	6	4	
WITH '				IPLETED WELL:			5 Latitude: 37.25246 (decimal degrees)				
	ON BOX:			Encountered: 1) 3) ft., or 4) [			Longitude: -97.39492 (decimal degrees) Horizontal Datum: □ WGS 84 ■ NAD 83 □ NAD 27				
1	N	WELL'S S	TATIC WA	TER LEVEL:4.	70 f		Source for Latitude/Longitude:				
		□ below	and surface	, measured on (mo-day	-vr) 12/14/20		3DQ (	unit make/model:	Spectra	Precision Epo	
NW	NE	above l	above land surface, measured on (mo-day-yr)				(WAAS enabled? ☐ Yes ■ No)				
		Pump test d	Pump test data: Well water was ft.				☐ Land Survey ☐ Topographic Map				
				s pumping gpm				e Mapper:			
1 1 '	SE			vater was							
	1	<b>I</b>		s pumping gpm				ı: 1183.95 <sub>ft</sub>	Œ Grou	nd Level □ TOC	
Estimated Yield:  Bore Hole Diameter:				gpm 8 in. to20			Land Survey				
						Bourt		Other			
7 WELL WATER TO BE USED AS:											
1. Domestic:   1. D											
				g: how many wells?	10. 🗀 C	11. Test Hole: well ID					
				echarge: well ID			☐ Uncased ☐				
☐ Livest	ock	8.	Monitorin	echarge: well IDg: well ID	/10R			al: how many bore			
2. Irrigat	2. Irrigation 9. Environmental Remediation: well ID							l Loop 🔲 Horizon			
3. Feedle							Open Loop   Surface Discharge   Inj. of Water				
4. Industrial Recovery Injection 13. Other (specify):											
Was a chemical/bacteriological sample submitted to KDHE? ☐ Yes ■ No If yes, date sample was submitted:											
Water well disinfected? ☐ Yes ■ No											
8 TYPE OF CASING USED: ☐ Steel ■ PVC ☐ Other											
Casing diameter 2 in to 5 ft., Diameter in to ft., Diameter in to ft., Diameter in to ft.  Casing height above land surface -9.48 in Weight lbs./ft. Wall thickness or gauge No. Sch. 40											
Casing height above land surface											
TYPE OF SCREEN OR PERFORATION MATERIAL:											
☐ Steel     ☐ Stainless Steel     ☐ Fiberglass     ☐ PVC     ☐ Other (Specify)       ☐ Brass     ☐ Galvanized Steel     ☐ Concrete tile     ☐ None used (open hole)											
SCREEN OR PERFORATION OPENINGS ARE:											
☐ Continuous Slot ■ Mill Slot ☐ Gauze Wrapped ☐ Torch Cut ☐ Drilled Holes ☐ Other (Specify)											
☐ Louvered Shutter ☐ Key Punched ☐ Wire Wrapped ☐ Saw Cut ☐ None (Open Hole)											
SCREEN-PERFORATED INTERVALS: From .5											
GRAVEL PACK INTERVALS: From											
9 GROUT MATERIAL: ☐ Neat cement ☐ Cement grout ■ Bentonite ■ Other Concrete											
Grout Intervals: From 0 ft. to 0.5 ft., From 0.5 ft. to 4 ft., From ft. to ft.											
Nearest sou	irce of possi	ble contaminat	ion:								
Septic			Lateral Line			Livestock P		☐ Insection		•	
Sewer			Cess Pool	☐ Sewage La		Fuel Storage		☐ Abando			
	tight Sewer I		Seepage Pit			Fertilizer St	orage	e ☐ Oil We	II/Gas We	<b>11</b>	
■ Other (Specify) .Remedial site											
10 FROM	TO		LITHOLO		FROM	ТО		HO. LOG (cont.) or		NG INTERVALS	
0	4	Clay, silty, B		<u></u>							
4	17	Sand, f-c w/		Brown				<del></del>			
17	20			yey, Lt. Gray Brn							
				<u>, ,,                                 </u>							
					Notes:						
11 CONT	RACTOR	S OR LAND	OWNER'	S CERTIFICATION	N: This wate	r well was	co	onstructed, 🗌 reco	nstructe	d, or 🗌 plugged	
under my j	urisdiction	and was comp	leted on (n	no-day-year) .10/19/	2020 and	this record	is tr	ue to the best of m	y knowle	edge and belief.	
Kansas Water Well Contractor's License No. 527. This Water Well Record was completed on (mo-day-year) 10/29/2020 under the business name of GeoCore LLC. Signature											
Mail	1 white conv	long with a fee of	\$5.00 for each	ch constructed well to: Ka	nsas Department	of Health and	Envi	ronment, Bureau of W	ater, GWT	S Section,	
Mail 1 white copy along with a fee of \$5.00 for each constructed well to: Kansas Department of Health and Environment, Bureau of Water, GWTS Section, 1000 SW Jackson St., Suite 420, Topeka, Kansas 66612-1367. Mail one to Water Well Owner and retain one for your records. Telephone 785-296-5524.											
Visit us at http://www.kdheks.gov/waterwell/index.html  KSA 82a-1212  Revised 7/10/2015											

KSA 82a-1212

Visit us at http://www.kdheks.gov/waterwell/index.html

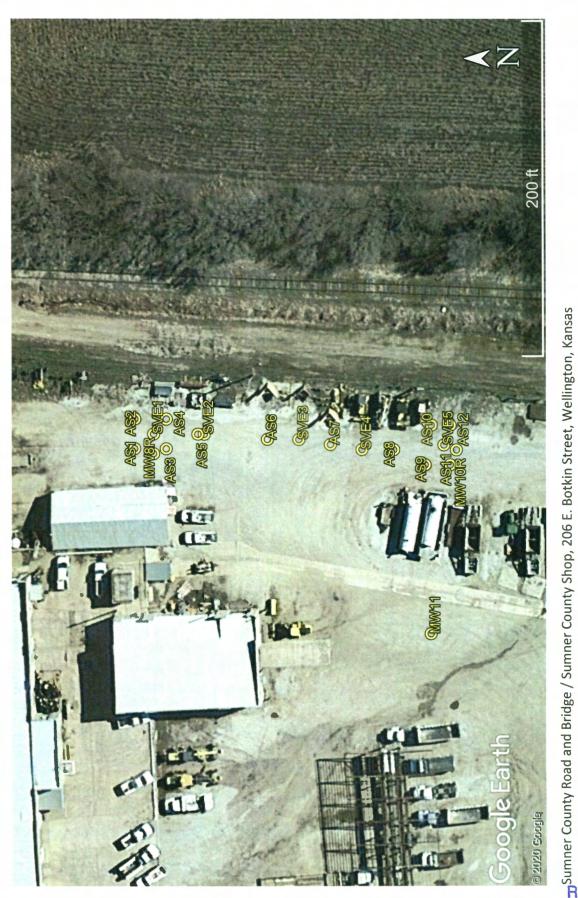

TKDHE Project Code: U2-096-00881 / A2-096-40065 О Surveyed)

37.25291, -97.39495 AS7: AS8: AS9: 37.25297, -97.39492 37.25297, -97.39486 37.25292, -97.39492 37.25292, -97.39486

37.25276, -97.39490 37.25256, -97.39492 37.25266, -97.39491

SVE3: 37.25271, -97.39490 SVE2: 37.25286, -97.39489 37.25251, -97.39495 AS11: 37.25247, -97.39495 AS10: 37.25250, -97.39487

37.25261, -97.39492 37.25248, -97.39491 SVE4: SVE5:

37.25294, -97.39489

37.25250, -97.39487

AS10:

37.25287, -97.39489

AS4: AS3:

AS5:

37.25247, -97.39487

AS12: SVE1:

APR 2 7 2021

AAS1: QAS2: