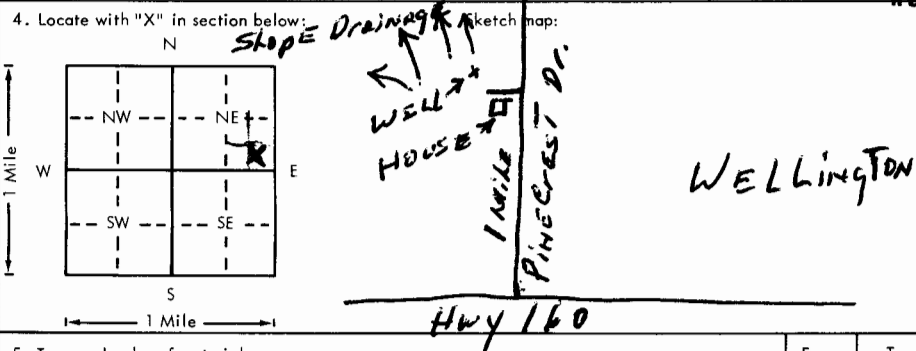


USE TYPEWRITER OR BALL
POINT PEN-PRESS FIRMLY,
PRINT CLEARLY.

XXXX

WATER WELL RECORD
KSA 82a-1201-1215

Kansas Department of Health and
Environment-Division of Environment
(Water well Contractors)
Topeka, Kansas 66620

1. Location of well:	County Sumner	Fraction SE 1/4 SE 1/4 NE 1/4	Section number 9	Township number T 32 S	Range number S R I W E/W
2. Distance and direction from nearest town or city: I mile North of hwy 160 on Pinecrest Drive		3. Owner of well: Chris M. Graig R.R. or street: RR#1 - Box 125 City, state, zip code: Wellington, Kan.			
4. Locate with "X" in section below: 		6. Bore hole dia. 8 in. Completion date 9/4/78 Well depth 45 ft.			
5. Type and color of material		From	To	7. <input checked="" type="checkbox"/> Cable tool <input type="checkbox"/> Rotary <input type="checkbox"/> Driven <input type="checkbox"/> Dug <input type="checkbox"/> Hollow rod <input type="checkbox"/> Jetted <input type="checkbox"/> Bored <input type="checkbox"/> Reverse rotary	
Topsoil		0	2	8. Use: <input type="checkbox"/> Domestic <input type="checkbox"/> Public supply <input type="checkbox"/> Industry <input type="checkbox"/> Irrigation <input type="checkbox"/> Air conditioning <input checked="" type="checkbox"/> Stock <input type="checkbox"/> Lawn <input type="checkbox"/> Oil field water <input type="checkbox"/> Other	
Light Bwn sticky clay		2	20	9. Casing: Material plastic Height: Above or below Threader <input checked="" type="checkbox"/> Welded <input type="checkbox"/> Surface A I2 in. RMP 6 PVC 45 Weight 13 lbs./ft. Dia. 6 in. to 45 ft. depth Wall Thickness: inches or Dia. 6 in. to 45 ft. depth Gauge No. 188	
Water bearing, light bwn sandy clay		20	40	10. Screen: Manufacturer's name Contractor perf. Type sawed Dia. 1/16" Slot/gauze slot Length 13" Set between 30 ft. and 43 ft. Gravel pack? yes Size range of material 12 to 20/8"	
Light bwn sand & gravel (1/16" to 3/4"		40	43	11. Static water level: 20 ft. below land surface Date 9/4/78	
Hard dark bwn clay - non-water bearing		43	45	12. Pumping level below land surfaces: 25 ft. after 3 hrs. pumping 25 g.p.m. 25 ft. after 1 hrs. pumping 25 g.p.m. Estimated maximum yield 40 g.p.m.	
				13. Water sample submitted: mo./day/yr. <input type="checkbox"/> Yes <input checked="" type="checkbox"/> No Date	
				14. Well head completion: <input type="checkbox"/> Pitless adapter 12" Inches above grade	
				15. Well grouted? By owner <input checked="" type="checkbox"/> With: <input type="checkbox"/> Neat cement <input type="checkbox"/> Bentonite <input checked="" type="checkbox"/> Concrete Depth: From 0 ft. to 10 ft.	
				16. Nearest source of possible contamination: ft. 250 Direction S Type Septic Well disinfected upon completion? <input type="checkbox"/> Yes <input checked="" type="checkbox"/> No	
				17. Pump: <input checked="" type="checkbox"/> Not installed Manufacturer's name Model number HP Volts Length of drop pipe ft. capacity g.p.m. Type: <input type="checkbox"/> Submersible <input type="checkbox"/> Turbine <input type="checkbox"/> Jet <input type="checkbox"/> Reciprocating <input type="checkbox"/> Centrifugal <input type="checkbox"/> Other	
				(Use a second sheet if needed)	
18. Elevation: Topography: <input checked="" type="checkbox"/> Hill <input type="checkbox"/> Slope <input type="checkbox"/> Upland <input type="checkbox"/> Valley	19. Remarks: Owner is a concrete contractor. He grouted the well and will latter install a concrete slab.				
		20. Water well contractor's certification: This well was drilled under my jurisdiction and this report is true to the best of my knowledge and belief. Gene C. Watkins - WL.Dlg. 374 Business name P.O.Box 27- Milan, Kan. License No. Address Signed Gene Watkins Date 10/3/78 Authorized representative			

Forward the white, blue and pink copies to the Department of Health and Environment

Form WWC-5