


1 LOCATION OF WATER WELL: County: <u>Sumner</u>	Fraction <u>SW</u> $\frac{1}{4}$ <u>SE</u> $\frac{1}{4}$ <u>SE</u> $\frac{1}{4}$	Section Number <u>10</u>	Township Number T <u>22</u> <u>S</u>	Range Number R <u>1</u> <u>EW</u>
--	---	-----------------------------	---	--------------------------------------

Distance and direction from nearest town or city street address of well if located within city?

1101 Poplar

2 WATER WELL OWNER: RR#, St. Address, Box # : City, State, ZIP Code : <u>Bill James</u> <u>1101 Poplar</u> <u>Wellington, KS 67152</u>	Board of Agriculture, Division of Water Resources Application Number: <u>74</u>
---	--

3 LOCATE WELL'S LOCATION WITH AN "X" IN SECTION BOX:	4 DEPTH OF COMPLETED WELL: <u>44</u> ft. ELEVATION:
--	---

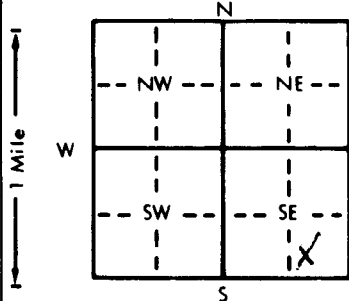

Depth(s) Groundwater Encountered	1. <u>22</u> ft.	2. <u>44</u> ft.	3. <u>44</u> ft.
WELL'S STATIC WATER LEVEL	<u>22</u> ft. below land surface measured on mo/day/yr		
Pump test data:	Well water was	ft. after	hours pumping
Est. Yield	gpm: Well water was	ft. after	hours pumping
Bore Hole Diameter	in. to	ft., and	in. to
WELL WATER TO BE USED AS:	5 Public water supply	8 Air conditioning	11 Injection well
1 Domestic	3 Feedlot	6 Oil field water supply	9 Dewatering
2 Irrigation	4 Industrial	<u>7</u> Lawn and garden only	12 Other (Specify below)
Was a chemical/bacteriological sample submitted to Department?	Yes	No <u>X</u>	If yes, mo/day/yr sample was submitted
Water Well Disinfected?	Yes <u>X</u>	No	

5 TYPE OF BLANK CASING USED:	5 Wrought iron	8 Concrete tile	CASING JOINTS: Glued <u>X</u> Clamped
1 Steel	3 RMP (SR)	6 Asbestos-Cement	9 Other (specify below)
<u>2</u> PVC	4 ABS	7 Fiberglass	Welded
Blank casing diameter	<u>5</u> in. to <u>24</u> ft., Dia	in. to	ft., Dia
Casing height above land surface	<u>18</u> in., weight <u>160</u> lbs./ft.	Wall thickness or gauge No.	
TYPE OF SCREEN OR PERFORATION MATERIAL:	<u>2</u> PVC	10 Asbestos-cement	
1 Steel	3 Stainless steel	5 Fiberglass	8 RMP (SR)
2 Brass	4 Galvanized steel	6 Concrete tile	9 ABS
SCREEN OR PERFORATION OPENINGS ARE:	5 Gauzed wrapped	8 Saw cut	11 None (open hole)
1 Continuous slot	<u>2</u> Mill slot	6 Wire wrapped	9 Drilled holes
2 Louvered shutter	4 Key punched	7 Torch cut	10 Other (specify)
SCREEN-PERFORATED INTERVALS:	From <u>22</u> ft. to <u>44</u> ft.	ft. to	ft. to
GRAVEL PACK INTERVALS:	From <u>22</u> ft. to <u>44</u> ft.	ft. to	ft. to

6 GROUT MATERIAL:	1 Neat cement	<u>2</u> Cement grout	3 Bentonite	4 Other
GROUT INTERVALS:	From <u>0</u> ft. to <u>20</u> ft.	ft. to	ft. to	ft. to
What is the nearest source of possible contamination:	1 Septic tank	4 Lateral lines	7 Pit privy	10 Livestock pens
2 Sewer lines	5 Cess pool	8 Sewage lagoon	11 Fuel storage	14 Abandoned water well
3 Watertight sewer lines	6 Seepage pit	9 Feedyard	12 Fertilizer storage	15 Oil well/Gas well
			13 Insecticide storage	16 Other (specify below)
				<u>Don't know</u>

Direction from well?	How many feet?
FROM	TO
<u>0</u>	<u>6</u>
<u>6</u>	<u>12</u>
<u>12</u>	<u>15</u>
<u>15</u>	<u>25</u>
<u>25</u>	<u>44</u>
LITHOLOGIC LOG	PLUGGING INTERVALS
<u>Brown Clay</u>	
<u>Red Clay</u>	
<u>tan clay</u>	
<u>green shale</u>	
<u>gray shale</u>	

7 CONTRACTOR'S OR LANDOWNER'S CERTIFICATION: This water well was (1) <u>constructed</u> , (2) reconstructed, or (3) plugged under my jurisdiction and was completed on (mo/day/year) <u>8-29-91</u> and this record is true to the best of my knowledge and belief. Kansas Water Well Contractor's License No. <u>506</u> This Water Well Record was completed on (mo/day/yr) <u>8-29-91</u> under the business name of <u>Metro Water Well Service</u> by (signature) <u>Danish metz</u>
