

1 LOCATION OF WATER WELL: County: <u>SUMNER</u>		Fraction <u>SE</u> $\frac{1}{4}$ <u>SW</u> $\frac{1}{4}$ <u>SW</u> $\frac{1}{4}$	Section Number <u>11</u>	Township Number T <u>32</u> S	Range Number R <u>1</u> EW
--	--	---	-----------------------------	----------------------------------	-------------------------------


2 WATER WELL OWNER: DEETA KAY ENTER.

RR#, St. Address, Box # : 119 w. 15th
City, State, ZIP Code : Wellington, KS

MWS
Board of Agriculture, Division of Water Resources
Application Number: ()

3 LOCATE WELL'S LOCATION WITH AN "X" IN SECTION BOX:

4 DEPTH OF COMPLETED WELL... 20 ... ft. ELEVATION: 1218.35 (Toc)

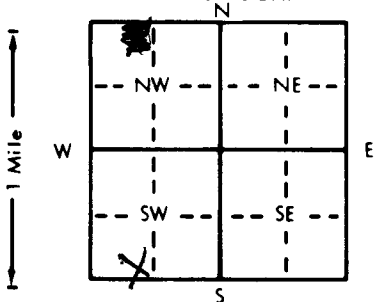

Depth(s) Groundwater Encountered 1. ft. 2. ft. 3. ft.

WELL'S STATIC WATER LEVEL 14.57 ft. below land surface measured on mo/day/yr

Pump test data: Well water was ft. after hours pumping gpm

Est. Yield gpm Well water was ft. after hours pumping gpm

Bore Hole Diameter 7 7/8 in. to ft., and in. to ft.

WELL WATER TO BE USED AS:

5 Public water supply	8 Air conditioning	11 Injection well
1 Domestic	3 Feedlot	6 Oil field water supply
2 Irrigation	4 Industrial	7 Lawn and garden only
		9 Dewatering
		10 Monitoring well
		12 Other (Specify below)

Was a chemical/bacteriological sample submitted to Department? Yes..... No.....; If yes, mo/day/yr sample was submitted

Water Well Disinfected? Yes No

5	TYPE OF BLANK CASING USED:
---	----------------------------

- Blank casing diameter 2 in. to 10 ft., Dia 2 in. to 19-20 ft., Dia Threaded.
- Casing height above land surface FLUSH in. weight 8 lbs./ft. Wall thickness or gauge No. 8

TYPE OF SCREEN OR PERFORATION MATERIAL:

- 1 Steel 3 Stainless steel 5 Fiberglass 8 RMP (SR) 11 Other (specify)
- 2 Brass 4 Galvanized steel 6 Concrete tile 9 ABS 12 None used (open hole)
- SCREEN OR PERFORATION OPENINGS ARE:
- 1 Continuous slot 3 Mill slot 5 Gauzed wrapped 8 Saw cut 11 None (open hole)
- 2 Louvered shutter 4 Key punched 6 Wire wrapped 9 Drilled holes
- 7 Torch cut 10 Other (specify)

SCREEN-PERFORATED INTERVALS: From 10 ft. to 19 ft. From 20 ft. to 29 ft.

GRAVEL PACK INTERVALS: From 8 ft. to 20 ft. From 20 ft. to 29 ft.

6 GROUT MATERIAL: 1 Neat cement 2 Cement grout 3 Bentonite 4 Other

What is the nearest source of possible contamination:

- | | | | | |
|--------------------------|-----------------|-----------------|------------------------|--------------------------|
| 1 Septic tank | 4 Lateral lines | 7 Pit privy | 11 Fuel storage | 15 Oil well/Gas well |
| 2 Sewer lines | 5 Cess pool | 8 Sewage lagoon | 12 Fertilizer storage | 16 Other (specify below) |
| 3 Watertight sewer lines | 6 Seepage pit | 9 Feedyard | 13 Insecticide storage | LIST EXCAVATION |

Direction from well?

How many feet?

[illegible]

7. CONTRACTOR'S OR LANDOWNER'S CERTIFICATION: This water well was (1) constructed, (2) reconstructed, or (3) plugged under my jurisdiction and was completed on (mo/day/year) 1/20/93 and this record is true to the best of my knowledge and belief. Kansas

Water Well Contractor's License No. 483 This Water Well Record was completed on (mo/day/yr) 4/10/83
under the business name of Total Environ. Services + Technology by (signature) Charles Hunter

INSTRUCTIONS: Use typewriter or ball point pen. PLEASE PRESS FIRMLY and PRINT clearly. Please fill in blanks, underline or circle the correct answers. Send top three copies to Kansas Department of Health and Environment, Bureau of Water, Topeka, Kansas 66620-0001. Telephone: 913-296-5545. Send one to WATER WELL OWNER and retain one for your records.