

BH-121 mw-9


WATER WELL RECORD Form WWC-5 KSA 82a-1212

1 LOCATION OF WATER WELL:	Fraction	Section Number	Township Number	Range Number
County: <u>Sumner</u>	<u>NW 1/4 NW 1/4 NW 1/4</u>	<u>13</u>	<u>T 32 S</u>	<u>R 1 EW</u>

Distance and direction from nearest town or city street address of well if located within city?
Hwy 160 East Wellington KS

2 WATER WELL OWNER:	Board of Agriculture, Division of Water Resources
RR#, St. Address, Box #:	Application Number:
City, State, ZIP Code:	
<u>Tom McAlister</u>	
<u>PO Box 96</u>	
<u>Wellington KS 67152</u>	

3 LOCATE WELL'S LOCATION WITH AN "X" IN SECTION BOX:	4 DEPTH OF COMPLETED WELL	ft. ELEVATION:
	<u>19.0</u>	<u>NA</u>

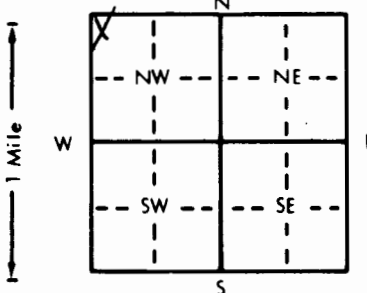

Depth(s) Groundwater Encountered	1	ft. 2	ft. 3	ft.
WELL'S STATIC WATER LEVEL	<u>10.01</u>	ft. below land surface measured on mo/day/yr	<u>7-28-92</u>	
Pump test data:	Well water was	ft. after	hours pumping	gpm
Est. Yield	gpm:	Well water was	ft. after	hours pumping
Bore Hole Diameter	<u>8</u>	in. to	ft. and	in. to
WELL WATER TO BE USED AS:	5 Public water supply	8 Air conditioning	11 Injection well	
1 Domestic	3 Feedlot	6 Oil field water supply	9 Dewatering	12 Other (Specify below)
2 Irrigation	4 Industrial	7 Lawn and garden only	<u>10 Monitoring well</u>	
Was a chemical/bacteriological sample submitted to Department?	Yes	No <u>X</u>	If yes, mo/day/yr sample was submitted	
Water Well Disinfected?	Yes	No <u>X</u>		

5 TYPE OF BLANK CASING USED:	5 Wrought iron	8 Concrete tile	CASING JOINTS: Glued	Clamped
1 Steel	3 RMP (SR)	6 Asbestos-Cement	9 Other (specify below)	Welded
<u>2 PVC</u>	4 ABS	7 Fiberglass		Threaded <u>Flush</u>

Blank casing diameter	<u>2</u>	in. to	ft., Dia	in. to	ft., Dia	in. to	ft., Dia
Casing height above land surface	<u>Flush</u>	in., weight	<u>70.3</u>	lbs./ft. Wall thickness or gauge No.	<u>154</u>		

TYPE OF SCREEN OR PERFORATION MATERIAL:	1 Steel	3 Stainless steel	5 Fiberglass	8 RMP (SR)	11 Other (specify)
2 Brass	4 Galvanized steel	6 Concrete tile	9 ABS	12 None used (open hole)	

SCREEN OR PERFORATION OPENINGS ARE:	5 Gauzed wrapped	8 Saw cut	11 None (open hole)
1 Continuous slot	<u>3 Mill slot</u>	6 Wire wrapped	9 Drilled holes
2 Louvered shutter	4 Key punched	7 Torch cut	10 Other (specify)

SCREEN-PERFORATED INTERVALS:	From	<u>8.55</u>	ft. to	<u>18.55</u>	ft., From	ft. to	ft.
GRAVEL PACK INTERVALS:	From	<u>7.0</u>	ft. to	<u>18.55</u>	ft., From	ft. to	ft.

6 GROUT MATERIAL:	1 Neat cement	2 Cement grout	<u>3 Bentonite</u>	4 Other			
Grout Intervals:	From	<u>7.0</u>	ft. to	<u>1.0</u>	ft., From	ft. to	ft.

What is the nearest source of possible contamination:	10 Livestock pens	14 Abandoned water well		
1 Septic tank	4 Lateral lines	7 Pit privy	<u>11 Fuel storage</u>	15 Oil well/Gas well
2 Sewer lines	5 Cess pool	8 Sewage lagoon	12 Fertilizer storage	16 Other (specify below)
3 Watertight sewer lines	6 Seepage pit	9 Feedyard	13 Insecticide storage	
Direction from well?	<u>West-North west</u>	How many feet?	<u>~1000'</u>	

FROM	TO	LITHOLOGIC LOG	FROM	TO	PLUGGING INTERVALS
0.0	9.0	Clay			
9.0	11.0	Sand, fine to medium, well sorted, clayey.			
11.0	12.0	Shale, weathered			
12.0	19.0	Shale			
Flush mount waiver granted on 6-10-92 for KDHE Trust Fund; McAlister Oil Co. by Don Taylor.					

7 CONTRACTOR'S OR LANDOWNER'S CERTIFICATION: This water well was	(1) constructed, (2) reconstructed, or (3) plugged under my jurisdiction and was completed on (mo/day/year)	<u>7-24-92</u>	and this record is true to the best of my knowledge and belief. Kansas Water Well Contractor's License No.	<u>531</u>	This Water Well Record was completed on (mo/day/yr)	<u>8-3-92</u>	under the business name of	<u>Geotechnical Services, Inc</u>	by (signature)	<u>Allison Irwin</u>
--	---	----------------	--	------------	---	---------------	----------------------------	-----------------------------------	----------------	----------------------