

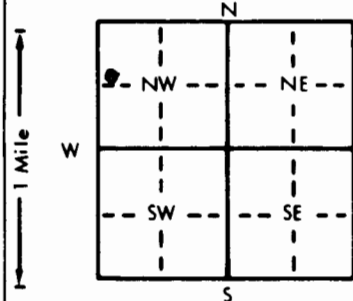
1 LOCATION OF WATER WELL:	Fraction	Section Number	Township Number	Range Number
County: <u>Sumner</u>	<u>SW</u> $\frac{1}{4}$ <u>NW</u> $\frac{1}{4}$ <u>NW</u> $\frac{1}{4}$	<u>14</u>	T <u>32</u> S	R <u>1</u> E (W)

Distance and direction from nearest town or city street address of well if located within city?

In Wellington

2 WATER WELL OWNER: <u>F.H. Langley</u>	Board of Agriculture, Division of Water Resources
RR#, St. Address, Box #: <u>620 N. 8th Street</u>	Application Number:
City, State, ZIP Code: <u>Wellington Ks. 67152</u>	

3 LOCATE WELL'S LOCATION WITH AN "X" IN SECTION BOX:	4 DEPTH OF COMPLETED WELL: <u>20'</u> ft. ELEVATION:
--	--

Depth(s) Groundwater Encountered 1. 12' ft. 2. ft. 3. ft.WELL'S STATIC WATER LEVEL 8.36 ft. below land surface measured on mo/day/yr 12-14-93

Pump test data: Well water was ft. after hours pumping gpm

Est. Yield gpm: Well water was ft. after hours pumping gpm

Bore Hole Diameter 7 1/2" in. to 20' ft., and in. to ft.

WELL WATER TO BE USED AS:

1 Domestic	3 Feedlot	6 Oil field water supply	9 Dewatering	12 Other (Specify below)
2 Irrigation	4 Industrial	7 Lawn and garden only	10 Monitoring well	

Was a chemical/bacteriological sample submitted to Department? Yes No X; If yes, mo/day/yr sample was submittedWater Well Disinfected? Yes No

5 TYPE OF BLANK CASING USED:	5 Wrought iron	8 Concrete tile	CASING JOINTS: Glued Clamped
------------------------------	----------------	-----------------	------------------------------

1 Steel 3 RMP (SR) 6 Asbestos-Cement 9 Other (specify below) Welded

2 PVC 4 ABS 7 Fiberglass Threaded XBlank casing diameter 2.375 in. to 10' ft., Dia in. to ft., Dia in. to ft.Casing height above land surface Flush Mount in., weight lbs./ft. Wall thickness or gauge No. SDR-13

TYPE OF SCREEN OR PERFORATION MATERIAL:

1 Steel 3 Stainless steel 5 Fiberglass 8 RMP (SR) 11 Other (specify)

2 Brass 4 Galvanized steel 6 Concrete tile 9 ABS 12 None used (open hole)

SCREEN OR PERFORATION OPENINGS ARE:

1 Continuous slot 3 Mill slot 5 Gauzed wrapped 8 Saw cut 11 None (open hole)

2 Louvered shutter 4 Key punched 6 Wire wrapped 9 Drilled holes

3 Torch cut 10 Other (specify)

SCREEN-PERFORATED INTERVALS: From 20' ft. to 10' ft., From ft. to ft.

From ft. to ft., From ft. to ft.

GRAVEL PACK INTERVALS: From 20' ft. to 8' ft., From ft. to ft.

From ft. to ft., From ft. to ft.

6 GROUT MATERIAL:	1 Neat cement	2 Cement grout	3 Bentonite	4 Other
-------------------	---------------	----------------	-------------	---------

Grout Intervals: From 8' ft. to 3' ft., From 3' ft. to 0' ft., From ft. to ft.

What is the nearest source of possible contamination:

1 Septic tank 4 Lateral lines 7 Pit privy 10 Livestock pens 14 Abandoned water well

2 Sewer lines 5 Cess pool 8 Sewage lagoon 11 Fuel storage 15 Oil well/Gas well

3 Watertight sewer lines 6 Seepage pit 9 Feedyard 12 Fertilizer storage 16 Other (specify below)

13 Insecticide storage

Direction from well? East How many feet? 5'

FROM	TO	LITHOLOGIC LOG	FROM	TO	PLUGGING INTERVALS
0	1'	Sand-Gravel-Cobble fill w/ drk. brown clay			
1	3.5	Drk. brown clay w/ ls rx & qtz. gravel			
		iron oxides			
3.5	7.75	Blk. silty clay			
7.75	13'	Gray-olive silty clay w/iron oxides			
		ls.rx. gravel & sand mottled			
13'	20'	Med.drk gray brown stiff mottled			
		sandy clay. Fine grained sand,			
		drk gray mottled clay banding			
		Fine -very course sand & gravel			

7 CONTRACTOR'S OR LANDOWNER'S CERTIFICATION: This water well was (1) <u>constructed</u> , (2) reconstructed, or (3) plugged under my jurisdiction and was completed on (mo/day/year) <u>12-14-93</u> and this record is true to the best of my knowledge and belief. Kansas Water Well Contractor's License No. <u>539</u> This Water Well Record was completed on (mo/day/yr) <u>12-28-93</u> under the business name of <u>JB Environmental Drilling</u> by (signature) <u>James Bieker</u>

INSTRUCTIONS: Use typewriter or ball point pen. PLEASE PRESS FIRMLY and PRINT clearly. Please fill in blanks, underline or circle the correct answers. Send top three copies to Kansas Department of Health and Environment, Bureau of Water, Topeka, Kansas 66620-0001. Telephone: 913-296-5545. Send one to WATER WELL OWNER and retain one for your records.