

1 LOCATION OF WATER WELL: Fraction NE 1/4 SW 1/4 NW 1/4 Section Number 15 Township Number T 32 S Range Number R 1 E/W  
 County: Sumner  
 Distance and direction from nearest town or city street address of well if located within city?  
See Below

2 WATER WELL OWNER: Mike Kelley


RR#, St. Address, Box # : 624 Sykes Wellington KS 67153

City, State, ZIP Code : Wellington KS 67153

Board of Agriculture, Division of Water Resources

Application Number:

3 LOCATE WELL'S LOCATION WITH AN "X" IN SECTION BOX:

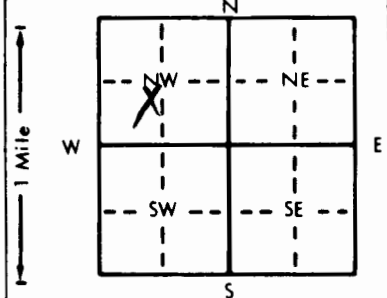

4 DEPTH OF COMPLETED WELL: 65 ft. ELEVATION: 34 ft.

Depth(s) Groundwater Encountered 1. 34 ft. 2. 34 ft. 3. 34 ft.

WELL'S STATIC WATER LEVEL 34 ft. below land surface measured on mo/day/yr 5-4-91

Pump test data: Well water was 60 ft. after 12 hours pumping 5 gpm

Est. Yield 5 gpm: Well water was 60 ft. after 12 hours pumping 5 gpm

Bore Hole Diameter 11 in. to 65 ft. and 65 in. to 65 ft.

WELL WATER TO BE USED AS: 5 Public water supply 8 Air conditioning 11 Injection well

1 Domestic 3 Feedlot 6 Oil field water supply 9 Dewatering 12 Other (Specify below)

2 Irrigation 4 Industrial Lawn and garden only 10 Monitoring well

Was a chemical/bacteriological sample submitted to Department? Yes X No X If yes, mo/day/yr sample was submitted

Water Well Disinfected? Yes X No X

5 TYPE OF BLANK CASING USED:

1 Steel 3 RMP (SR)

2 PVC 4 ABS

Blank casing diameter 5 in. to 30 ft. Dia. 5 in. to 30 ft. Dia. 5 in. to 30 ft.

Casing height above land surface 12 in. weight 2.69 lbs./ft. Wall thickness or gauge No. 160 PVC

TYPE OF SCREEN OR PERFORATION MATERIAL:

1 Steel 3 Stainless steel 5 Fiberglass 8 RMP (SR)

2 Brass 4 Galvanized steel 6 Concrete tile 9 ABS

SCREEN OR PERFORATION OPENINGS ARE:

1 Continuous slot 3 Mill slot 5 Gauzed wrapped 8 Saw cut 11 None (open hole)

2 Louvered shutter 4 Key punched 6 Wire wrapped 9 Drilled holes

SCREEN-PERFORATED INTERVALS: From 30 ft. to 65 ft. From 30 ft. to 65 ft.

GRAVEL PACK INTERVALS: From 22 ft. to 65 ft. From 22 ft. to 65 ft.



6 GROUT MATERIAL:

1 Neat cement 2 Cement grout 3 Bentonite 4 Other

Grout Intervals: From 2 ft. to 22 ft. From 2 ft. to 22 ft.

What is the nearest source of possible contamination:

1 Septic tank 4 Lateral lines 7 Pit privy 10 Livestock pens 14 Abandoned water well

2 Sewer lines 5 Cess pool 8 Sewage lagoon 11 Fuel storage 15 Oil well/Gas well

3 Watertight sewer lines 6 Seepage pit 9 Feedyard 12 Fertilizer storage 16 Other (specify below)

Direction from well? South

How many feet? 30

FROM TO LITHOLOGIC LOG FROM TO PLUGGING INTERVALS

0 2 top so.

2 24 clay.

24 32 fine sand.

32 38 clay.

38 65 shale.

7 CONTRACTOR'S OR LANDOWNER'S CERTIFICATION: This water well was (1) constructed, (2) reconstructed, or (3) plugged under my jurisdiction and was completed on (mo/day/year) 5-4-91 and this record is true to the best of my knowledge and belief. Kansas

Water Well Contractor's License No. 318 This Water Well Record was completed on (mo/day/yr) 5-26-91

under the business name of Winning Wells by (signature) [Signature]