


1 LOCATION OF WATER WELL: County: Sumner Fraction SW 1/4 SE 1/4 NW 1/4 Section Number 15 Township Number T 32 S Range Number R 1 E

Distance and direction from nearest town or city street address of well if located within city?

See Below

2 WATER WELL OWNER: FRANCIS CARR
RR#, St. Address, Box #: #43 CRESTWAY
City, State, ZIP Code: WELLINGTON KS 67152
Board of Agriculture, Division of Water Resources
Application Number:

3 LOCATE WELL'S LOCATION WITH AN "X" IN SECTION BOX:

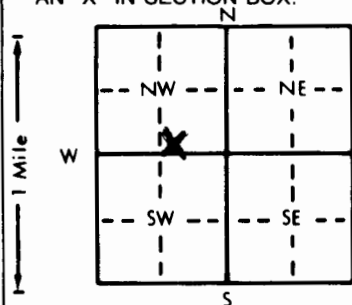

4 DEPTH OF COMPLETED WELL: 60 ft. ELEVATION:

Depth(s) Groundwater Encountered 1. 28 ft. 2. 28 ft. 3. 28 ft.

WELL'S STATIC WATER LEVEL 28 ft. below land surface measured on mo/day/yr 5-2-91

Pump test data: Well water was 30 ft. after 2 hours pumping 20 gpm

Est. Yield 20-30 gpm Well water was 30 ft. after 2 hours pumping 20 gpm

Bore Hole Diameter 11 in. to 60 ft. and 60 in. to 60 ft.

WELL WATER TO BE USED AS: 5 Public water supply 8 Air conditioning 11 Injection well

1 Domestic 3 Feedlot 6 Oil field water supply 9 Dewatering 12 Other (Specify below)

2 Irrigation 4 Industrial 7 Lawn and garden only 10 Monitoring well

Was a chemical/bacteriological sample submitted to Department? Yes X No X; If yes, mo/day/yr sample was submitted

Water Well Disinfected? Yes X No X

5 TYPE OF BLANK CASING USED: 5 Wrought iron 8 Concrete tile CASING JOINTS: Glued X Clamped

1 Steel 3 RMP (SR) 6 Asbestos-Cement 9 Other (specify below) Welded

2 PVC 4 ABS 7 Fiberglass Threaded

Blank casing diameter 5 in. to 25 ft. Dia 2 in. to 60 ft. Dia 160 PVC

Casing height above land surface 12 in. weight 2 lbs./ft. Wall thickness or gauge No. 160

TYPE OF SCREEN OR PERFORATION MATERIAL: 7 PVC 10 Asbestos-cement

1 Steel 3 Stainless steel 5 Fiberglass 8 RMP (SR) 11 Other (specify)

2 Brass 4 Galvanized steel 6 Concrete tile 9 ABS 12 None used (open hole)

SCREEN OR PERFORATION OPENINGS ARE: 5 Gauzed wrapped 8 Saw cut 11 None (open hole)

1 Continuous slot 3 Mill slot 6 Wire wrapped 9 Drilled holes

2 Louvered shutter 4 Key punched 7 Torch cut 10 Other (specify)

SCREEN-PERFORATED INTERVALS: From 25 ft. to 60 ft. From 25 ft. to 60 ft.

GRAVEL PACK INTERVALS: From 23 ft. to 60 ft. From 23 ft. to 60 ft.




6 GROUT MATERIAL: 1 Neat cement 2 Cement grout 3 Bentonite 4 Other

Grout intervals: From 3 ft. to 23 ft. From 3 ft. to 23 ft.

What is the nearest source of possible contamination: 10 Livestock pens 14 Abandoned water well

1 Septic tank 4 Lateral lines 7 Pit privy 11 Fuel storage 15 Oil well/Gas well

2 Sewer lines 5 Cess pool 8 Sewage lagoon 12 Fertilizer storage 16 Other (specify below)

3 Watertight sewer lines 6 Seepage pit 9 Feedyard 13 Insecticide storage

Direction from well? EAST How many feet? 80

FROM TO LITHOLOGIC LOG FROM TO PLUGGING INTERVALS

0 2 Top 50.1

2 21 CLAY.

21 37 fine to med sand

37 60 Chalk/SHALE