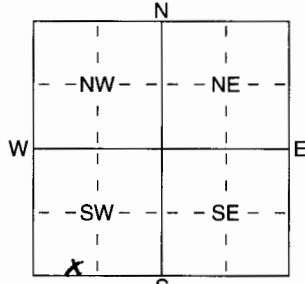


1 LOCATION OF WATER WELL: Fraction SE 1/4 SW 1/4 SW 1/4 Section Number 12 Township Number T 32 S Range Number R 11 E/W  
 County: Burber

Distance and direction from nearest town or city street address of well if located within city?

2 WATER WELL OWNER: Kelly Hrencher  
 RR#, St. Address, Box #: 3906 Southeast Hwy 160 Board of Agriculture, Division of Water Resources  
 City, State, ZIP Code: Medicine Lodge, KS 67104 Application Number: 46 018

3 LOCATE WELL'S LOCATION WITH AN "X" IN SECTION BOX:  
  
 4 DEPTH OF COMPLETED WELL 6.0 ft. ELEVATION: ..... ft.  
 Depth(s) Groundwater Encountered 1 7 ft. 2 ..... ft. 3 ..... ft.  
 WELL'S STATIC WATER LEVEL 7 ft. below land surface measured on mo/day/yr .....  
 Pump test data: Well water was ..... ft. after ..... hours pumping ..... gpm  
 Est. Yield 200 gpm: Well water was ..... ft. after ..... hours pumping ..... gpm  
 WELL WATER TO BE USED AS: 5 Public water supply 8 Air conditioning 11 Injection well  
 1 Domestic 3 Feedlot 6 Oil field water supply 9 Dewatering 12 Other (Specify below)  
 Irrigation 4 Industrial 7 Domestic (lawn & garden) 10 Monitoring well .....  
 Was a chemical/bacteriological sample submitted to Department? Yes ..... No .....; If yes, mo/day/yr sample was submitted  
 Water Well Disinfected?  Yes No

5 TYPE OF BLANK CASING USED: 5 Wrought iron 8 Concrete tile CASING JOINTS: Glued  Clamped .....  
 1 Steel 3 RMP (SR) 6 Asbestos-Cement 9 Other (specify below) Welded .....  
 PVC 4 ABS 7 Fiberglass ..... Threaded .....  
 Blank casing diameter 16 in. to 20 ft., Dia ..... in. to ..... ft., Dia ..... in. to ..... ft.  
 Casing height above land surface 12 in., weight sch 40 lbs./ft. Wall thickness or guage No. ....  
 TYPE OF SCREEN OR PERFORATION MATERIAL:  PVC 10 Asbestos-Cement  
 1 Steel 3 Stainless Steel 5 Fiberglass 8 RMP (SR) 11 Other (Specify) .....  
 2 Brass 4 Galvanized Steel 6 Concrete tile 9 ABS 12 None used (open hole)  
 SCREEN OR PERFORATION OPENINGS ARE: 5 Guazed wrapped 8 Saw cut 11 None (open hole)  
 1 Continuous slot  Mill slot 6 Wire wrapped 9 Drilled holes  
 2 Louvered shutter 4 Key punched 7 Torch cut 10 Other (specify) ..... ft.  
 SCREEN-PERFORATED INTERVALS: From 30 ft. to 60 ft., From ..... ft. to ..... ft.  
 From ..... ft. to ..... ft., From ..... ft. to ..... ft.  
 GRAVEL PACK INTERVALS: From 20 ft. to 60 ft., From ..... ft. to ..... ft.  
 From ..... ft. to ..... ft., From ..... ft. to ..... ft.

6 GROUT MATERIAL: 1 Neat cement 2 Cement grout  Bentonite 4 Other .....  
 Grout Intervals: From 0 ft. to 20 ft., From ..... ft. to ..... ft., From ..... ft. to ..... ft.  
 What is the nearest source of possible contamination:  
 1 Septic tank 4 Lateral lines 7 Pit privy 10 Livestock pens 14 Abandoned water well  
 2 Sewer lines 5 Cess pool 8 Sewage lagoon 11 Fuel storage 15 Oil well/Gas well  
 3 Watertight sewer lines 6 Seepage pit 9 Feedyard 12 Fertilizer storage 16 Other (specify below)  
 13 Insecticide storage ..... NA  
 Direction from well? How many feet? NA

FROM	TO	LITHOLOGIC LOG	FROM	TO	PLUGGING INTERVALS
0	6	Fine Sand silt			
6	9	Sandy clay			
9	20	Sand Medium			
20	60	Sand + Clay mix			

7 CONTRACTOR'S OR LANDOWNER'S CERTIFICATION: This water well was (1) constructed, (2) reconstructed, or (3) plugged under my jurisdiction and was completed on (mo/day/year) 5-10-05 and this record is true to the best of my knowledge and belief. Kansas Water Well Contractor's Licence No 177 This Water Well Record was completed on (mo/day/yr) 5-25-05 under the business name of CLT Inc. by (signature) CLT

INSTRUCTIONS: Use typewriter or ball point pen. PLEASE PRESS FIRMLY and PRINT clearly. Please fill in blanks, underline or circle the correct answers. Send top three copies to Kansas Department of Health and Environment, Bureau of Water, Geology Section, 1000 SW Jackson St., Suite 420, Topeka, Kansas 66612-1367. Telephone 785-296-5522. Send one to WATER WELL OWNER and retain one for your records. Fee of \$5.00 for each constructed well.