


1 LOCATION OF WATER WELL: County: Deer Fraction: SE 1/4 SW 1/4 SW 1/4 Section Number: 12 Township Number: T 32 S Range Number: R 11 E/W

Distance and direction from nearest town or city street address of well if located within city?

2 WATER WELL OWNER: Kelly Hrencher
 RR#, St. Address, Box # : 3906 Southeast Hwy 166 Board of Agriculture, Division of Water Resources
 City, State, ZIP Code : Medicine Lodge KS 67104 Application Number: 76,018

3 LOCATE WELL'S LOCATION WITH AN "X" IN SECTION BOX:

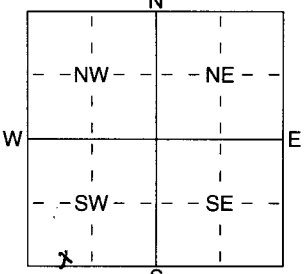

4 DEPTH OF COMPLETED WELL: 62 ft. ELEVATION: _____ ft.

Depth(s) Groundwater Encountered: 1 _____ ft. 2 _____ ft. 3 _____ ft.

WELL'S STATIC WATER LEVEL: 7 ft. below land surface measured on mo/day/yr _____

Pump test data: Well water was _____ ft. after _____ hours pumping _____ gpm

Est. Yield: 5.50 gpm: Well water was _____ ft. after _____ hours pumping _____ gpm

WELL WATER TO BE USED AS:

1 Domestic	3 Feedlot	5 Public water supply	8 Air conditioning	11 Injection well
2 Irrigation	4 Industrial	6 Oil field water supply	9 Dewatering	12 Other (Specify below)
		7 Domestic (lawn & garden)	10 Monitoring well	

Was a chemical/bacteriological sample submitted to Department? Yes _____ No _____; If yes, mo/day/yr sample was submitted _____

Water Well Disinfected? Yes _____ No _____

5 TYPE OF BLANK CASING USED:

1 Steel	3 RMP (SR)	5 Wrought iron	8 Concrete tile	CASING JOINTS: Glued _____ Clamped _____
2 PVC	4 ABS	6 Asbestos-Cement	9 Other (specify below)	Welded _____
		7 Fiberglass		Threaded _____

Blank casing diameter: 16 in. to 3.2 ft., Dia _____ in. to _____ ft., Dia _____ in. to _____ ft.

Casing height above land surface: 12 in., weight: 5.4 40 lbs./ft. Wall thickness or gauge No. _____

TYPE OF SCREEN OR PERFORATION MATERIAL:

1 Steel	3 Stainless Steel	5 Fiberglass	8 RMP (SR)	10 Asbestos-Cement
2 Brass	4 Galvanized Steel	6 Concrete tile	9 ABS	11 Other (Specify) _____
				12 None used (open hole)

SCREEN OR PERFORATION OPENINGS ARE:

1 Continuous slot	2 Mill slot	5 Gauzed wrapped	8 Saw cut	11 None (open hole)
2 Louvered shutter	4 Key punched	6 Wire wrapped	9 Drilled holes	
		7 Torch cut	10 Other (specify) _____	ft.

SCREEN-PERFORATED INTERVALS: From 3.2 ft. to 60 ft., From _____ ft. to _____ ft.

GRAVEL PACK INTERVALS: From 2.0 ft. to 6.0 ft., From _____ ft. to _____ ft.

6 GROUT MATERIAL: 1 Neat cement Cement grout Bentonite 4 Other _____

Grout Intervals: From 0 ft. to 2.0 ft., From _____ ft. to _____ ft., From _____ ft. to _____ ft.

What is the nearest source of possible contamination:

1 Septic tank	4 Lateral lines	7 Pit privy	10 Livestock pens	14 Abandoned water well
2 Sewer lines	5 Cess pool	8 Sewage lagoon	11 Fuel storage	15 Oil well/Gas well
3 Watertight sewer lines	6 Seepage pit	9 Feedyard	12 Fertilizer storage	16 Other (specify below)
			13 Insecticide storage	<u>NA</u>

Direction from well? _____ How many feet? _____

FROM	TO	LITHOLOGIC LOG	FROM	TO	PLUGGING INTERVALS
0	6	Fine Sand + Silt			
6	9	Sand, Clay			
9	20	Sand Medium to Coarse Loose			
20	22	Brown Clay			
22	32	Sand Medium			
32	60	Sand Medium to Coarse Loose			
60	65	Red Shale			

7 CONTRACTOR'S OR LANDOWNER'S CERTIFICATION: This water well was (1) constructed, (2) reconstructed, or (3) plugged under my jurisdiction and was completed on (mo/day/year) 5-3-05 and this record is true to the best of my knowledge and belief. Kansas Water Well Contractor's Licence No 677 This Water Well Record was completed on (mo/day/yr) 5-25-05 under the business name of CLT Inc. by signature CLT 99