


1 LOCATION OF WATER WELL:	Fraction	Section Number	Township Number	Range Number
County: <u>Barber</u>	<u>SE 1/4 SE 1/4 SW 1/4</u>	<u>12</u>	<u>32</u>	<u>11</u> EW

Distance and direction from nearest town or city street address of well if located within city?
From Pixley Rd. And Walstead Rd go 2 1/2 miles east on Walstead well

2 WATER WELL OWNER: <u>Kelly Hrencher</u>	<u>on the north side</u> <u>1500 FT.</u>
RR #, St. Address, Box #: <u>3906 SE Hwy 160</u>	Board of Agriculture, Division of Water Resources
City, State, ZIP Code: <u>Medicine Lodge KS</u>	Application Number:

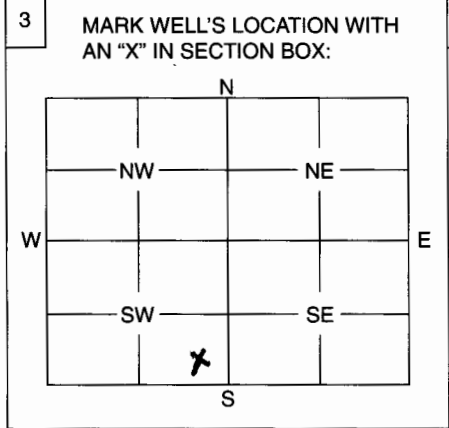

4 DEPTH OF WELL 60 ft.

WELL'S STATIC WATER LEVEL 16 ft.

WELL WAS USED AS:

1 Domestic	5 Public Water Supply	9 Dewatering
<u>2 Irrigation</u>	6 Oil Field Water Supply	10 Monitoring Well
3 Feedlot	7 Domestic (Lawn & Garden)	11 Injection Well
4 Industrial	8 Air Conditioning	12 Other

Was a chemical / bacteriological sample submitted to Department? Yes No

If yes, mo/day/yr sample was submitted

Water Well Disinfected: Yes No

5 TYPE OF BLANK CASING USED:

1 Steel	3 RMP (SR)	5 Wrought	7 Fiberglass	9 Other (Specify below)
<u>2 PVC</u>	4 ABS	6 Asbestos-Cement	8 Concrete Tile

Blank casing diameter 16 in. Was casing pulled? Yes No If yes, how much 4 ft

Casing height above or below land surface -4 ft in.

6 GROUT PLUG MATERIAL: 1 Neat cement 2 Cement grout 3 Bentonite 4 Other

Grout Plug Intervals: From 60 ft. to 4 ft., From ft. to ft., From to ft.

What is the nearest source of possible contamination:

1 Septic tank	6 Seepage pit	<u>11 Fuel storage</u>	16 Other (specify below)
2 Sewer lines	7 Pit privy	12 Fertilizer storage
3 Watertight sewer lines	8 Sewage lagoon	13 Insecticide storage
4 Lateral lines	9 Feedyard	14 Abandoned water well
5 Cess pool	10 Livestock pens	15 Oil well/Gas well

Direction from well? west How many feet? 300 ft

FROM	TO	PLUGGING MATERIALS
<u>60</u>	<u>4</u>	<u>Bentonite grout</u>

7 CONTRACTOR'S OF LANDOWNER'S CERTIFICATION: This water well was plugged under my jurisdiction and was completed on (mo/day/year) 6-16-06 and this record is true to the best of my knowledge and belief. Kansas Water Well Contractor's License No. 665 This Water Well Record was completed on (mo/day/year) 6-20-06 under the business name of Pratt Well Envs. by (signature) Stuart Zell

INSTRUCTIONS: Use typewriter or ball point pen. Please press firmly and print clearly. Please fill in blanks, underline or circle the correct answers. Send top three copies to Kansas Department of Health and Environment, Bureau of Water, Geology Section, 1000 SW Jackson St., Ste. 420, Topeka, Kansas 66612-1367. Telephone: 785/296-5522. Send one to Water Well Owner and retain one for your records.