

WATER WELL RECORD

Form WWC-5


Division of Water Resources App. No.

48,303

1 LOCATION OF WATER WELL: County: Barber Fraction 1/4 NW 1/4 NE 1/4 NW 1/4 Section Number 13 Township No. T 32 S Range Number R 11 E W

Street/Rural Address of Well Location; if unknown, distance & direction from nearest town or intersection: 1/2 South, 5 1/2 East of Medicine Lodge Global Positioning System (GPS) information: Latitude: Longitude: Elevation: Datum: Collection Method: Est. Accuracy:

2 WATER WELL OWNER: Kelly Hrencher RR#, Street Address, Box #: 3906 SE US Hwy 160 City, State, ZIP Code : Medicine Lodge, KS 67104

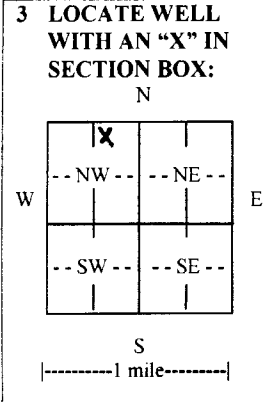

3 LOCATE WELL WITH AN 'X' IN SECTION BOX: 4 DEPTH OF COMPLETED WELL 60 ft. Depth(s) Groundwater Encountered (1) 14 ft. (2) ft. (3) ft. WELL'S STATIC WATER LEVEL 14 ft. below land surface measured on mo/day/yr. 11-12-13 Pump test data: Well water was ft. after hours pumping gpm EST. YIELD N/A gpm. Well water was ft. after hours pumping gpm Bore Hole Diameter 40 in. to 52 ft., and 26 in. to 60 ft. WELL WATER TO BE USED AS: Irrigation checked. Was a chemical/bacteriological sample submitted to Department? No checked. Water well disinfected? Yes checked.

5 TYPE OF CASING USED: PVC checked. CASING JOINTS: Glued checked. Casing diameter 16 in. to 60 ft., Diameter in. to ft., Diameter in. to ft. Casing height above land surface 18 in., Weight Sch 40 lbs./ft., Wall thickness or gauge No. TYPE OF SCREEN OR PERFORATION MATERIAL: PVC checked. SCREEN OR PERFORATION OPENINGS ARE: Saw cut checked. SCREEN-PERFORATED INTERVALS: From 60 ft. to 20 ft., From ft. to ft., From ft. to ft. GRAVEL PACK INTERVALS: From 60 ft. to 20 ft., From ft. to ft., From ft. to ft.

6 GROUT MATERIAL: Bentonite checked. Grout Intervals: From 20 ft. to 0 ft., From ft. to ft., From ft. to ft. What is the nearest source of possible contamination: Other (specify below) checked. Direction from well Distance from well

Table with 6 columns: FROM, TO, LITHOLOGIC LOG, FROM, TO, LITHO. LOG (cont.) or PLUGGING INTERVALS. Rows include Top soil, Brown clay, Sand & gravel w/ clay streaks, Sand & gravel- med to large, Brown clay w/ sand & gravel mix, Brown clay, Small sand & gravel, Red shale- brittle.

7 CONTRACTOR'S OR LANDOWNER'S CERTIFICATION: This water well was constructed checked, reconstructed, or plugged under my jurisdiction and was completed on (mo/day/year) 12-19-13 and this record is true to the best of my knowledge and belief. Kansas Water Well Contractor's License No. 134 This Water Well Record was completed on (mo/day/year) 12-27-13 under the business name of Rosencrantz- Bemis Ent Inc by (signature) Kara Cileja

INSTRUCTIONS: Use typewriter or ball point pen. PLEASE PRESS FIRMLY and PRINT clearly. Please fill in blanks and check the correct answers. Send three copies (white, blue, pink) to Kansas Department of Health and Environment, Bureau of Water, Geology Section, 1000 SW Jackson St., Suite 420, Topeka, Kansas 66612-1367. Telephone 785-296-5524. Send one copy to WATER WELL OWNER and retain one for your records. Include fee of \$5.00 for each constructed well. Visit us at http://www.kdheks.gov/waterwell/index.html.