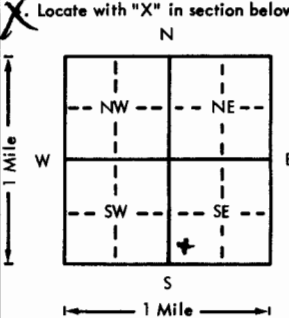


USE TYPEWRITER OR BALL POINT PEN-PRESS FIRMLY, PRINT CLEARLY.

WATER WELL RECORD
KSA 82a-1201-1215

Kansas Department of Health and Environment-Division of Environment
(Water well Contractors)
Topeka, Kansas 66620

1. Location of well:		County Barber	Section <input checked="" type="checkbox"/> SW 1/4 <input type="checkbox"/> SW 4 <input checked="" type="checkbox"/> SW 7	Section number 6	Township number T 32 S R 11 E/W	Range number 11	<input checked="" type="checkbox"/>
2. Distance and direction from nearest town or city: 1E ML			3. Owner of well: Alvin Capansky R.R. or street: RR Medicine, Lpd 3 Ks City, state, zip code: 67104				
<input checked="" type="checkbox"/> Locate with "X" in section below: 		Sketch map:		6. Bore hole dia. 5 in. Completion date 4-19-78 Well depth 59 ft.			
5. Type and color of material				From	To	7. <input checked="" type="checkbox"/> Cable tool <input checked="" type="checkbox"/> Rotary <input type="checkbox"/> Driven <input type="checkbox"/> Dug <input type="checkbox"/> Hollow rod <input type="checkbox"/> Jetted <input type="checkbox"/> Bored <input type="checkbox"/> Reverse rotary	
		soil and sand		0	5	8. Use: <input checked="" type="checkbox"/> Domestic <input type="checkbox"/> Public supply <input type="checkbox"/> Industry <input type="checkbox"/> Irrigation <input type="checkbox"/> Air conditioning <input type="checkbox"/> Stock <input type="checkbox"/> Lawn <input type="checkbox"/> Oil field water <input type="checkbox"/> Other	
		clay		5	10	9. Casing: Material _____ Height: Above or below Threaded _____ Welded _____ Surface 20 in. RMP _____ PVC <input checked="" type="checkbox"/> Weight 292 lbs./ft. Dia. 5 in. to 59 ft. depth Wall Thickness: inches or Dia. _____ in. to _____ ft. depth Gauge No. 258	
		sand		10	15	10. Screen: Manufacturer's name _____ Pumpeo Type PVG Dia. 5 Slot/gauze 40 Length 5 Set between _____ ft. and _____ ft. _____ ft. and _____ ft. Gravel pack? <input checked="" type="checkbox"/> Size range of material 1/2 in	
		clay		15	18	11. Static water level: _____ mo./day/yr. 4 ft. below land surface Date 4-19-78	
		sand		18	25	12. Pumping level below land surfaces: _____ ft. after _____ hrs. pumping _____ g.p.m. _____ ft. after _____ hrs. pumping _____ g.p.m. Estimated maximum yield 25 g.p.m.	
		clay		25	41	13. Water sample submitted: _____ mo./day/yr. Yes <input type="checkbox"/> No <input checked="" type="checkbox"/> Date _____	
		sand		41	45	<input checked="" type="checkbox"/> Well head completion: <input type="checkbox"/> Pitless adapter _____ inches above grade	
		clay		45	58	15. Well grouted? <input checked="" type="checkbox"/> With: <input checked="" type="checkbox"/> Neat cement <input type="checkbox"/> Bentonite <input type="checkbox"/> Concrete Depth: From 0 ft. to 10 ft.	
		shale		58	59	16. Nearest source of possible contamination: ft. 75 Direction N Type septic Well disinfected upon completion? <input checked="" type="checkbox"/> Yes <input type="checkbox"/> No	
						17. Pump: <input checked="" type="checkbox"/> Not installed Manufacturer's name _____ Model number _____ HP _____ Volts _____ Length of drop pipe _____ ft. capacity _____ g.p.m. Type: <input type="checkbox"/> Submersible <input type="checkbox"/> Turbine <input type="checkbox"/> Jet <input type="checkbox"/> Reciprocating <input type="checkbox"/> Centrifugal <input type="checkbox"/> Other	
						20. Water well contractor's certification: This well was drilled under my jurisdiction and this report is true to the best of my knowledge and belief. Lyman Bros. 140 Business name License No. Address Medicine Lad ge Signed W.A. Lyman Date 5-1 Authorized representative	
18. Elevation:		19. Remarks: Customer to build pump house					
Topography: <input type="checkbox"/> Hill <input type="checkbox"/> Slope <input type="checkbox"/> Upland <input type="checkbox"/> Valley							

T 32 S R 11 E
 Sec 6
 1/4 1/4 N E

Forward the white, blue and pink copies to the Department of Health and Environment

Form WWC-5