USE TYPEWRITER OR BALL POINT PEN-PRESS FIRMLY, PRINT CLEARLY.

WATER WELL RECORD
KSA 82a-1201-1215

Kansas Department of Health and Environment-Division of Environment
(Water well Contractors)
Topeka, Kansas 66620

| 1. Location of well: | County | Fraction | Section number | Township number | Range number |
|---|---|---|---|---|---|
| | Barber | SE 1/4 SE 1/4 SW 1/4 | 11 | T 32 S | R 11 E/W |

2. Distance and direction from nearest town or city: 3½ W Sharon
Street address of well location if in city:

3. Owner of well: Clarence Hrencher
R.R. or street: Sharon, Ks.
City, state, zip code:

4. Locate with "X" in section below:

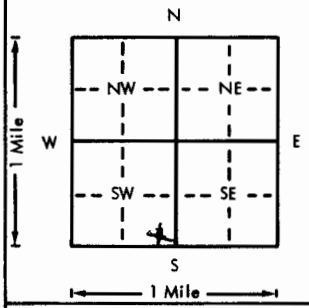


Sketch map:

6. Bore hole dia. 8 in. Completion date 9-1-76
Well depth 57 ft.

7. __ Cable tool X Rotary __ Driven __ Dug
__ Hollow rod __ Jetted __ Bored __ Reverse rotary

8. Use: X Domestic __ Public supply __ Industry
__ Irrigation __ Air conditioning __ Stock
__ Lawn __ Oil field water __ Other

9. Casing: Material ____ Height: Above or below
Threaded ____ Welded ____ Surface 15 in.
RMP ____ PVC X Weight 155 lbs./ft.
Dia. 4 in. to 57 ft. depth Wall Thickness: inches or
Dia. ____ in. to ____ ft. depth gage No. 160

5. Type and color of material

| | From | To |
|---|---|---|
| fime sand | 0 | 4 |
| medium sand | 4 | 15 |
| mud | 15 | 21 |
| meeium sand | 21 | 29 |
| silt | 29 | 35 |
| med sand | 35 | 42 |
| finesilty sand | 42 | 55 |
| shale | 55 | 57 |

(Use a second sheet if needed)

10. Screen: Manufacturer's name Peerless
Type pvc Dia. 4"
Slot/gauze 035 Length 5'
Set between 37 ft. and 42 ft.
____ ft. and ____ ft.
Gravel pack? X Size range of material ½ dn

11. Static water level: mo./day/yr.
6 ft. below land surface Date 9-1-76

12. Pumping level below land surfaces:
____ ft. after ____ hrs. pumping ____ g.p.m.
____ ft. after ____ hrs. pumping ____ g.p.m.
Estimated maximum yield 25 g.p.m.

13. Water sample submitted: mo./day/yr.
__ Yes X No Date

14. Well head completion:
X Pitless adapter 15 Inches above grade

15. Well grouted? X
With X Neat cement __ Bentonite __ Concrete
Depth: From 5 ft. to 15 ft.

16. Nearest source of possible contamination:
ft. field Direction ____ Type ____
Well disinfected upon completion? ____ Yes ____ No

17. Pump: __ Not installed
Manufacturer's name Dempster
Model number ____ HP ½ Volts 230
Length of drop pipe 36 ft. capacity 12 g.p.m.
Type:
X Submersible __ Turbine
__ Jet __ Reciprocating
__ Centrifugal __ Other

18. Elevation:

Topography:
__ Hill
__ Slope
__ Upland
__ Valley

19. Remarks:

customer to pour cement

20. Water well contractor's certification:
This well was drilled under my jurisdiction and this report is true to the best of my knowledge and belief.
Business name Lyman Bros. License No. 140
Address Mt
Signed W H Lyman Date 11-2
Authorized representative

32 T — 11 R E/W — 11 Sec — SESESW 1/4 1/4 1/4

Forward the white, blue and pink copies to the Department of Health and Environment

Form WWC-5

MI-1023