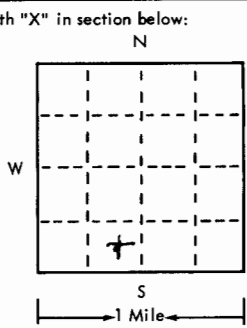
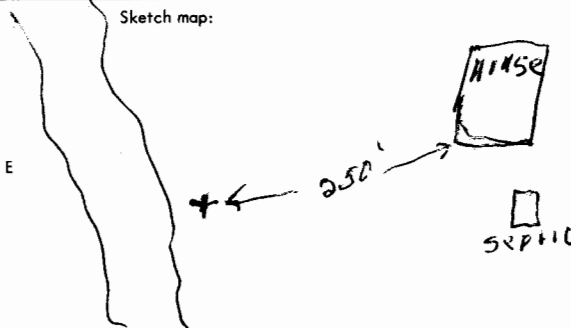


USE TYPEWRITER OR BALL POINT PEN-PRESS FIRMLY, PRINT CLEARLY.

WATER WELL RECORD
KSA 82a-1201-1215

T R EW sec 1/4 1/4 1/4 No.

Kansas State Dept. Of Health
(Water Well Contractors)
Forbes-Bldg. 740
Topeka, Kansas 66620

1 Location of well:	County BARBER	Township name	Fraction SE SE SW	Section number 13	Town number 32	Range number 11 W ^X	
Distance and direction from nearest town or city: Street address of well location if in city: 2 1/2 M E DIXLEY			3 Owner of well: LENNIS RANKIN Address: NASHVILLE MS				
Locate with "X" in section below: 			Sketch map: 			4 Well depth: 63 ft. Date of completion 3-24-75 Well diameter 8 in.	
2 Type and color of material			From To			5 <input type="checkbox"/> Cable tool <input checked="" type="checkbox"/> Rotary <input type="checkbox"/> Driven <input type="checkbox"/> Dug <input type="checkbox"/> Hollow rod <input type="checkbox"/> Jetted <input type="checkbox"/> Bored <input type="checkbox"/> Reverse rotary	
						6 Use: <input checked="" type="checkbox"/> Domestic <input type="checkbox"/> Public supply <input type="checkbox"/> Industry <input type="checkbox"/> Irrigation <input type="checkbox"/> Air conditioning <input type="checkbox"/> Commercial <input type="checkbox"/> Test well <input type="checkbox"/>	
SANDY SOIL			0			7 Casing: Material PVC Weight: above below Threading <input type="checkbox"/> Welded <input checked="" type="checkbox"/> Surface 3/4 in. Digm. 4 in. to 63 ft. depth! Drive shoe? <input type="checkbox"/> Yes <input checked="" type="checkbox"/> No	
SAND			4			8 Screen: Manufacturer Peerless Type PVC Dia. 4 1/2 Slot/gauze 0.35 Length 70 Set between 53 ft. and 63 ft.	
CLAY			10			Fittings: 5 DN Gravel pack <input checked="" type="checkbox"/> Yes <input checked="" type="checkbox"/> No Size range of material	
SILTY SAND			25			9 Static water level: 8 ft. below land surface Date 3-25-76	
CLAY			34			10 Pumping level below land surfaces: ____ ft. after ____ hrs. pumping ____ g.p.m. ____ ft. after ____ hrs. pumping ____ g.p.m. Estimated maximum yield 50 g.p.m.	
MED SAND			49			11 Water sample submitted: <input type="checkbox"/> Yes <input checked="" type="checkbox"/> No Date	
SHALE			62			12 Well head completion: 24 <input checked="" type="checkbox"/> Pitless adapter <input type="checkbox"/> Inches above grade	
						13 Well grouted? <input checked="" type="checkbox"/> Yes <input type="checkbox"/> No <input checked="" type="checkbox"/> Neat cement <input type="checkbox"/> Bentonite <input type="checkbox"/> Depth: From 3 ft. to 15 ft.	
						14 Nearest source of possible contamination: FLOOD ft. 100 Direction W Type Well disinfected upon completion? <input checked="" type="checkbox"/> Yes <input type="checkbox"/> No	
						15 Pump: <input type="checkbox"/> Not installed Manufacturer's name JACUZZI Model number 754C HP 3/4 Volts 230 Length of drop pipe 42 ft. capacity 15 g.m.p. Type: <input checked="" type="checkbox"/> Submersible <input type="checkbox"/> Turbine <input type="checkbox"/> Jet <input type="checkbox"/> Reciprocating <input type="checkbox"/> Centrifugal <input type="checkbox"/> Other	
16 Remarks: elevation CRI 100 PPM Hd 15 gr CEMENT SLAB TO BE INSTALLED BY CUSTOMER						17 Water well contractor's certification: This well was drilled under my jurisdiction and this report is true to the best of my knowledge and belief. LYMAN BROS 140 Business name License No. Address M L O Signed W H Lyman Date 3-24-75 Authorized representative	

32 11W 13 SE SE SW

Forward the white, blue and pink copies to the Kansas State Dept. Of Health.

Form WWC-5