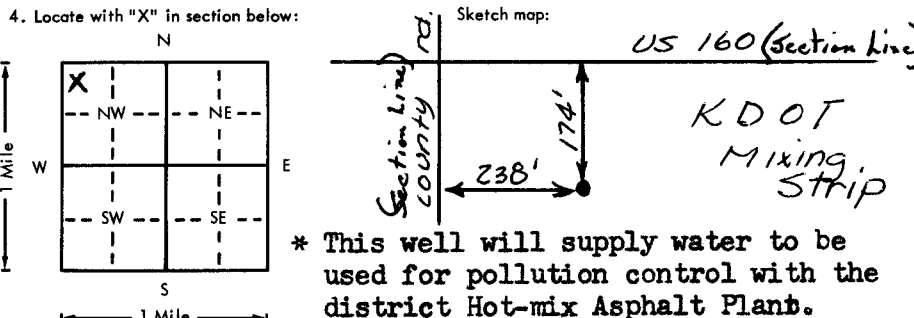


USE TYPEWRITER OR BALL POINT PEN-PRESS FIRMLY, PRINT CLEARLY.

WATER WELL RECORD
KSA 82a-1201-1215

Kansas Department of Health and Environment-Division of Environment (Water well Contractors) Topeka, Kansas 66620

1. Location of well:	County Barber	Fraction NW 1/4 NW 1/4 NW 1/4	Section number 22	Township number 32	Range number 1A
2. Distance and direction from nearest town or city: Medicine Lodge approx. 4 mi. east, south of U S 160			3. Owner of well: Kansas Department of Transport. Fifth District Hutchinson Kansas		
4. Locate with "X" in section below: 			6. Bore hole dia. 12 in. Completion date 8-21-80 Well depth 51 ft.		
5. Type and color of material			7. <input checked="" type="checkbox"/> Cable tool Rotary <input type="checkbox"/> Driven <input type="checkbox"/> Dug <input type="checkbox"/> Hollow rod <input type="checkbox"/> Jetted <input type="checkbox"/> Bored <input type="checkbox"/> Reverse rotary		
Soil-mantle, sandy, brown			8. Use: <input type="checkbox"/> Domestic <input type="checkbox"/> Public supply <input checked="" type="checkbox"/> Industry* <input type="checkbox"/> Irrigation <input type="checkbox"/> Air conditioning <input type="checkbox"/> Stock <input type="checkbox"/> Lawn <input type="checkbox"/> Oil field water <input type="checkbox"/> Other		
Sand, v.fine, silty, orange-tan to orange-brown			9. Casing: Material PVC Height: Above or below Threaded <input type="checkbox"/> Welded <input type="checkbox"/> Surface 18 in. RMP <input type="checkbox"/> PVC Schlo Weight 3.584 lbs./ft. Dia. 6 in. to 47.8 in. depth Wall Thickness: inches or Dia. <input type="checkbox"/> in. to <input type="checkbox"/> ft. depth gage No. .280		
Silt, clayey and sl. sandy (v. fine), contains some caliche, orange-tan			10. Screen: Manufacturer's name Pumpco slotted PVC SDR-26 (class 160) Type PVC Dia. 6 inch Slot/gage <input type="checkbox"/> Length 29.7 Set between 18.1 ft. and 47.8 ft. ft. and <input type="checkbox"/> ft. Gravel pack? yes Size range of material 1/16 to 3/8		
Sand and Gravel, contains considerable silt binder, orange-red			11. Static water level: <input type="checkbox"/> mo./day/yr. 14.5 ft. below land surface Date 8-21-80		
Sand and Gravel, fairly clean, contains slight amount of orange silt binder.			12. Pumping level below land surfaces: 24.2 ft. after 3 hrs. pumping 50 g.p.m. <input type="checkbox"/> ft. after <input type="checkbox"/> hrs. pumping <input type="checkbox"/> g.p.m. Estimated maximum yield 20-25 g.p.m.		
Gravel with coarse sand, clean			13. Water sample submitted: <input type="checkbox"/> Yes <input checked="" type="checkbox"/> No Date <input type="checkbox"/>		
Shale, silty, orange (Redbeds) [Cedar Hills Fm.]			14. Well head completion: <input type="checkbox"/> Pitless adapter 18 Inches above grade		
Shale, fairly firm, orange-maroon			15. Well grouted? yes With: <input checked="" type="checkbox"/> Neat cement <input checked="" type="checkbox"/> Bentonite <input type="checkbox"/> Concrete Depth: From 20 ft. to 1 ft.		
Shale, (as above) but contains some thin hard sandstone stringers below			16. Nearest source of possible contamination: None ft. <input type="checkbox"/> Direction <input type="checkbox"/> Type <input type="checkbox"/> Well disinfected upon completion? <input type="checkbox"/> Yes <input type="checkbox"/> No		
T.D.			17. Pump: <input checked="" type="checkbox"/> Not installed Manufacturer's name <input type="checkbox"/> Model number <input type="checkbox"/> HP <input type="checkbox"/> Volts <input type="checkbox"/> Length of drop pipe <input type="checkbox"/> ft. capacity <input type="checkbox"/> g.p.m. Type: <input type="checkbox"/> Submersible <input type="checkbox"/> Turbine <input type="checkbox"/> Jet <input type="checkbox"/> Reciprocating <input type="checkbox"/> Centrifugal <input type="checkbox"/> Other		
(Use a second sheet if needed)			20. Water well contractor's certification: This well was drilled under my jurisdiction and this report is true to the best of my knowledge and belief. Business name <input type="checkbox"/> License No. <input type="checkbox"/> Address <input type="checkbox"/> Signed <input type="checkbox"/> Date <input type="checkbox"/> Authorized representative		
18. Elevation: 1510	19. Remarks:		20. Water well contractor's certification:		
Topography: <input type="checkbox"/> Hill <input type="checkbox"/> Slope <input checked="" type="checkbox"/> Upland <input type="checkbox"/> Valley					

3 2 1 1 W 2 2 1/4 NW 1/4 NW 1/4

Forward the white, blue and pink copies to the Department of Health and Environment

Form WWC-5