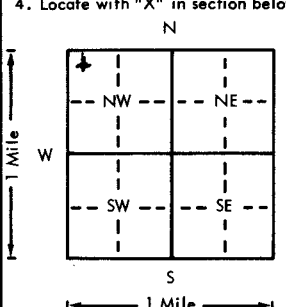
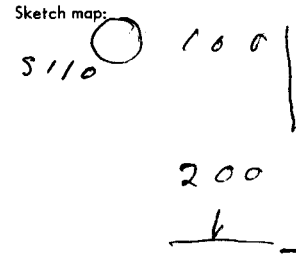


USE TYPEWRITER OR BALL POINT PEN-PRESS FIRMLY, PRINT CLEARLY.

WATER WELL RECORD  
KSA 82a-1201-1215

Kansas Department of Health and Environment-Division of Environment (Water well Contractors) Topeka, Kansas 66620

1. Location of well:	County <b>Barber</b>	Fraction <b>NW 1/4 NW 1/4 NW 1/4</b>	Section number <b>23</b>	Township number <b>32</b>	Range number <b>11</b>
2. Distance and direction from nearest town or city: Street address of well location if in city: <b>NE 28 Med Lodge</b>			3. Owner of well: <b>Howard Thoman</b> R.R. or street: <b>Sharon Ks.</b> City, state, zip code:		
4. Locate with "X" in section below: 			Sketch map: 		
5. Type and color of material			From	To	6. Bore hole dia. <b>10</b> in. Completion date <b>6-4-77</b> Well depth <b>30</b> ft.
soil			0	3	7. Cable tool <input checked="" type="checkbox"/> Rotary <input type="checkbox"/> Driven <input type="checkbox"/> Dug <input type="checkbox"/> Hollow rod <input type="checkbox"/> Jetted <input type="checkbox"/> Bored <input type="checkbox"/> Reverse rotary
clay			3	18	8. Use: <input checked="" type="checkbox"/> Domestic <input type="checkbox"/> Public supply <input type="checkbox"/> Industry <input type="checkbox"/> Irrigation <input type="checkbox"/> Air conditioning <input type="checkbox"/> Stock <input type="checkbox"/> Lawn <input type="checkbox"/> Oil field water <input type="checkbox"/> Other
fine silty sand			18	20	9. Casing: Material _____ Height: <u>Above</u> or below Threaded _____ Welded _____ Surface <b>15</b> in. RMP _____ PVC <input checked="" type="checkbox"/> Weight <b>292</b> lbs./ft. Dia. <b>5</b> in. to <b>30</b> ft. depth Wall Thickness: inches or Dia. _____ in. to _____ ft. depth gage No. <b>258</b>
med " "			20	24	10. Screen: Manufacturer's name <b>Fearless</b> Type <b>PVC</b> Dia. <b>5</b> Slot/gauze <b>0.35</b> Length <b>5</b> Set between <b>19</b> ft. and <b>24</b> ft. _____ ft. and _____ ft. Gravel pack? <input checked="" type="checkbox"/> Size range of material <b>20</b>
shale			24	30	11. Static water level: _____ mo./day/yr. <b>15</b> ft. below land surface Date <b>6-4-77</b>
					12. Pumping level below land surfaces: _____ ft. after _____ hrs. pumping _____ g.p.m. _____ ft. after _____ hrs. pumping _____ g.p.m. Estimated maximum yield _____ g.p.m.
					13. Water sample submitted: _____ mo./day/yr. Yes <input type="checkbox"/> No <input checked="" type="checkbox"/> Date _____
					14. Well head completion: <input checked="" type="checkbox"/> Pitless adapter <b>15</b> inches above grade
					15. Well grouted? <input checked="" type="checkbox"/> With: <input checked="" type="checkbox"/> Neat cement <input type="checkbox"/> Bentonite <input type="checkbox"/> Concrete Depth: From <b>3</b> ft. to <b>13</b> ft.
					16. Nearest source of possible contamination: ft. <b>200</b> Direction <b>N</b> Type <b>lot</b> Well disinfected upon completion? <input checked="" type="checkbox"/> Yes <input type="checkbox"/> No
					17. Pump: _____ Not installed Manufacturer's name <b>Dempster</b> Model number _____ HP <b>2</b> Volts <b>230</b> Length of drop pipe <b>24</b> ft. capacity <b>15</b> g.p.m. Type: <input checked="" type="checkbox"/> Submersible <input type="checkbox"/> Turbine <input type="checkbox"/> Jet <input type="checkbox"/> Reciprocating <input type="checkbox"/> Centrifugal <input type="checkbox"/> Other
(Use a second sheet if needed)					
18. Elevation:  Topography: <input type="checkbox"/> Hill <input type="checkbox"/> Slope <input checked="" type="checkbox"/> Upland <input type="checkbox"/> Valley	19. Remarks:  <b>Slab to be poured by customer</b>		20. Water well contractor's certification: This well was drilled under my jurisdiction and this report is true to the best of my knowledge and belief. <b>Lyman Bros</b> <b>140</b> Business name License No. Address <b>ML</b> Signed <b>W. J. Lyman</b> Date <b>6-9-77</b> Authorized representative		

113  
 112  
 110  
 109  
Forward the white, blue and pink copies to the Department of Health and Environment

Form WWC-5