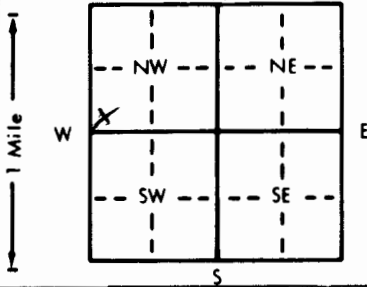


MW-6 2311014

1 LOCATION OF WATER WELL: Fraction SW 1/4 SW 1/4 NW 1/4 Section Number 12 Township Number T 32 S Range Number R 12 EW  
 County: BARBER

Distance and direction from nearest town or city street address of well if located within city?  
JCT. 281 AND 160

2 WATER WELL OWNER: ECMER SMITH OIL COMPANY Board of Agriculture, Division of Water Resources  
 RR#, St. Address, Box #: PO Box 1719 Application Number:  
 City, State, ZIP Code: CLINTON, OK 73601

3 LOCATE WELL'S LOCATION WITH AN "X" IN SECTION BOX:  


4 DEPTH OF COMPLETED WELL: 12.5 ft. ELEVATION:  
 Depth(s) Groundwater Encountered 1. 7.1 ft. 2. ft. 3. ft.  
 WELL'S STATIC WATER LEVEL: 6.80 ft. below land surface measured on 8/18/95  
 Pump test data: Well water was ft. after hours pumping gpm  
 Est. Yield gpm: Well water was ft. after hours pumping gpm  
 Bore Hole Diameter: 8 in. to ft. and in. to ft.  
 WELL WATER TO BE USED AS:  
 5 Public water supply 8 Air conditioning 11 Injection well  
 1 Domestic 3 Feedlot 6 Oil field water supply 9 Dewatering 12 Other (Specify below)  
 2 Irrigation 4 Industrial 7 Lawn and garden only 10 Monitoring well  
 Was a chemical/bacteriological sample submitted to Department? Yes No X; If yes, mo/day/yr sample was submitted  
 Water Well Disinfected? Yes No X

5 TYPE OF BLANK CASING USED:  
 1 Steel 3 RMP (SR) 5 Wrought iron 8 Concrete tile CASING JOINTS: Glued Clamped  
2 PVC 4 ABS 7 Fiberglass Threaded FLUSH  
 Blank casing diameter 2 in. to ft. Dia. in. to ft. Dia. in. to ft. Dia. in. to ft.  
 Casing height above land surface: FLUSH in., weight .703 lbs./ft. Wall thickness or gauge No. 154  
 TYPE OF SCREEN OR PERFORATION MATERIAL:  
 1 Steel 3 Stainless steel 5 Fiberglass 8 RMP (SR) 10 Asbestos-cement  
 2 Brass 4 Galvanized steel 6 Concrete tile 9 ABS 12 None used (open hole)  
 SCREEN OR PERFORATION OPENINGS ARE:  
 1 Continuous slot 3 Mill slot 5 Gauzed wrapped 8 Saw cut 11 None (open hole)  
 2 Louvered shutter 4 Key punched 6 Wire wrapped 9 Drilled holes  
 7 Torch cut 10 Other (specify)  
 SCREEN-PERFORATED INTERVALS: From 2.5 ft. to 12.5 ft. From ft. to ft.  
 GRAVEL PACK INTERVALS: From 2.0 ft. to 12.5 ft. From ft. to ft.

6 GROUT MATERIAL: 1 Neat cement 2 Cement grout 3 Bentonite 4 Other  
 Grout Intervals: From 2.0 ft. to 0.5 ft. From ft. to ft. From ft. to ft.  
 What is the nearest source of possible contamination:  
 1 Septic tank 4 Lateral lines 7 Pit privy 11 Fuel storage 14 Abandoned water well  
 2 Sewer lines 5 Cess pool 8 Sewage lagoon 12 Fertilizer storage 15 Oil well/Gas well  
 3 Watertight sewer lines 6 Seepage pit 9 Feedyard 13 Insecticide storage 16 Other (specify below)

Direction from well? NORTHWEST AND SOUTHWEST How many feet? 100 AND 120, RESPECTIVELY

FROM	TO	LITHOLOGIC LOG	FROM	TO	PLUGGING INTERVALS
0	0.5	ASPHALT			
0.5	11.5	SILT			
11.5	12.5	SILT, WITH SAND, FINE GRAINS			

7 CONTRACTOR'S OR LANDOWNER'S CERTIFICATION: This water well was constructed (2) reconstructed, or (3) plugged under my jurisdiction and was completed on (mo/day/year) 8/18/95 and this record is true to the best of my knowledge and belief. Kansas Water Well Contractor's License No. 531 This Water Well Record was completed on (mo/day/yr) 8/21/95 under the business name of GSI by (signature) Steve Nudler

OFFICE USE ONLY  
T  
R  
EW  
SEC.  
1/4  
1/4  
1/4