


MW-3 2311014

1 LOCATION OF WATER WELL: County: <b>BARBER</b>	Fraction: <b>SW 1/4 SW 1/4 NW 1/4</b>	Section Number: <b>12</b>	Township Number: <b>T 32 S</b>	Range Number: <b>R 12 E</b>
--	---------------------------------------	---------------------------	--------------------------------	-----------------------------

Distance and direction from nearest town or city street address of well if located within city?  
**Jct. 281 AND 160**

2 WATER WELL OWNER: **ELMER SMITH OIL COMPANY**  
 RR#, St. Address, Box #: **PO Box 1719**  
 City, State, ZIP Code: **CLINTON, OK 73601**

Board of Agriculture, Division of Water Resources  
 Application Number:

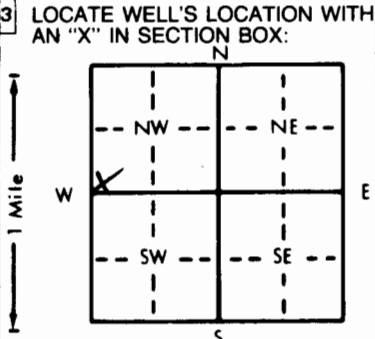

4 DEPTH OF COMPLETED WELL: **14** ft. ELEVATION: .....

Depth(s) Groundwater Encountered 1. **8.0** ft. 2. .... ft. 3. .... ft.

WELL'S STATIC WATER LEVEL: **6.75** ft. below land surface measured on mo/day/yr **8/18/95**

Pump test data: Well water was ..... ft. after ..... hours pumping ..... gpm

Est. Yield ..... gpm: Well water was ..... ft. after ..... hours pumping ..... gpm

Bore Hole Diameter: **8** in. to ..... ft., and ..... in. to ..... ft.

WELL WATER TO BE USED AS:

5 Public water supply	8 Air conditioning	11 Injection well
1 Domestic	3 Feedlot	6 Oil field water supply
2 Irrigation	4 Industrial	7 Lawn and garden only
		<b>10 Monitoring well</b>
		12 Other (Specify below)

Was a chemical/bacteriological sample submitted to Department? Yes.....No.....**X**..... If yes, mo/day/yr sample was submitted

Water Well Disinfected? Yes ..... No **X**

5 TYPE OF BLANK CASING USED:

1 Steel	3 RMP (SR)	5 Wrought iron	8 Concrete tile	CASING JOINTS: Glued ..... Clamped .....
<b>2 PVC</b>	4 ABS	6 Asbestos-Cement	9 Other (specify below)	Welded .....
		7 Fiberglass		Threaded .....

Blank casing diameter: **2** in. to ..... ft., Dia ..... in. to ..... ft., Dia ..... in. to ..... ft.

Casing height above land surface: **FLUSH** in., weight **703** lbs./ft. Wall thickness or gauge No. **154**

TYPE OF SCREEN OR PERFORATION MATERIAL:

1 Steel	3 Stainless steel	5 Fiberglass	8 RMP (SR)	10 Asbestos-cement
2 Brass	4 Galvanized steel	6 Concrete tile	9 ABS	11 Other (specify) .....
				12 None used (open hole)

SCREEN OR PERFORATION OPENINGS ARE:

1 Continuous slot	<b>3 Mill slot</b>	5 Gauzed wrapped	8 Saw cut	11 None (open hole)
2 Louvered shutter	4 Key punched	6 Wire wrapped	9 Drilled holes	
		7 Torch cut	10 Other (specify) .....	

SCREEN-PERFORATED INTERVALS: From **4.0** ft. to **14.0** ft., From ..... ft. to ..... ft.

GRAVEL PACK INTERVALS: From **2.0** ft. to **14.0** ft., From ..... ft. to ..... ft.

6 GROUT MATERIAL: 1 Neat cement 2 Cement grout **3 Bentonite** 4 Other .....

Grout intervals: From **2.0** ft. to **0.5** ft., From ..... ft. to ..... ft., From ..... ft. to ..... ft.

What is the nearest source of possible contamination:

1 Septic tank	4 Lateral lines	7 Pit privy	<b>11 Fuel storage</b>	14 Abandoned water well
2 Sewer lines	5 Cess pool	8 Sewage lagoon	12 Fertilizer storage	15 Oil well/Gas well
3 Watertight sewer lines	6 Seepage pit	9 Feedyard	13 Insecticide storage	16 Other (specify below)

Direction from well? **SOUTH** How many feet? **50 AND 140**

FROM	TO	LITHOLOGIC LOG	FROM	TO	PLUGGING INTERVALS
0	0.5	GRAVEL AND SILT			
<del>0.5</del>	<del>2.0</del>	<del>SILT, SLIGHTLY CLAYEY</del>			
0.5	11.0	SILT, SLIGHTLY CLAYEY			
11.0	14.0	SILT, LITTLE SAND, FINE TO MED GRAINS			

7 CONTRACTOR'S OR LANDOWNER'S CERTIFICATION: This water well was **(1) constructed**, (2) reconstructed, or (3) plugged under my jurisdiction and was completed on (mo/day/year) **8/18/95** and this record is true to the best of my knowledge and belief. Kansas Water Well Contractor's License No. **531** This Water Well Record was completed on (mo/day/yr) **8/21/95** under the business name of **GST** by (signature) **Steve Nudler**

OFFICE USE ONLY  
T  
R  
EW  
SEC.  
1/4  
1/4  
1/4