

WATER WELL RECORD

Form WWC-5

Division of Water Resources; App. No.


1 LOCATION OF WATER WELL: County: Barber	Fraction SE ¼ NE ¼ NE ¼	Section Number 11	Township Number T 32 S	Range Number R 12 (W)
---	-----------------------------------	-----------------------------	----------------------------------	---------------------------------

Distance and direction from nearest town or city street address of well if located within city?
210 S. Iliff, Medicine Lodge, Kansas

Global Positioning System (decimal degrees, min. of 4 digits)
Latitude: _____
Longitude: _____
Elevation: _____
Datum: _____
Data Collection Method: _____

2 WATER WELL OWNER: **Crescent Oil Co. - Jerry Davidson**
RR#, St. Address, Box # : **PO BOX 667**
City, State, ZIP Code : **Independence, KS 67301**

3 LOCATE WELL'S LOCATION WITH AN "X" IN SECTION BOX:

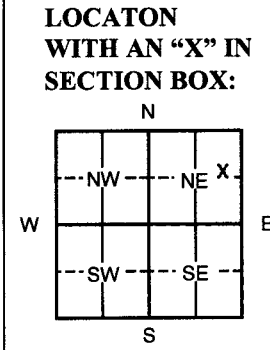

4 DEPTH OF COMPLETED WELL 23' ft.

Depth(s) Groundwater Encountered 1 ~15' ft. 2 _____ ft. 3 _____ ft.
WELL'S STATIC WATER LEVEL N/A ft. below land surface measured on mo/day/yr N/A
Pump test data: Well water was _____ ft. after _____ hours pumping _____ gpm
Est. Yield _____ gpm: Well water was _____ ft. after _____ hours pumping _____ gpm
WELL WATER TO BE USED AS: 5 Public water supply 8 Air conditioning 11 Injection well
1 Domestic 3 Feed lot 6 Oil field water supply 9 Dewatering 12 Other (Specify below)
2 Irrigation 4 Industrial 7 Domestic (lawn & garden) **(10 Monitoring well)**

Was a chemical/bacteriological sample submitted to Department? Yes _____ No **X**; If yes, mo/day/yr
Sample was submitted _____ Water Well Disinfected? Yes _____ No **X**

5 TYPE OF CASING USED: 5 Wrought Iron 8 Concrete tile CASING JOINTS: Glued _____ Clamped _____
1 Steel 3 RMP (SR) 6 Asbestos-Cement 9 Other (specify below) Welded _____
(2 PVC) 4 ABS 7 Fiberglass Threaded **X**
Blank casing diameter 2 in. to 13 ft., Dia _____ in. to _____ ft., Dia _____ in. to _____ ft.
Casing height below land surface N/A in., Weight _____ lbs./ft. Wall thickness or gauge No. **Sch. 40 PVC**

TYPE OF SCREEN OR PERFORATION MATERIAL:
1 Steel 3 Stainless steel 5 Fiberglass **(7 PVC)** 9 ABS 11 Other (specify) _____
2 Brass 4 Galvanized steel 6 Concrete tile 8 RM (SR) 10 Asbestos-Cement 12 None used (open hole)

SCREEN OR PERFORATION OPENINGS ARE:
1 Continuous slot **(3 Mill slot)** 5 Guaze wrapped 7 Torch cut 9 Drilled holes 11 None (open hole)
2 Louvered shutter 4 Key punched 6 Wire wrapped 8 Saw Cut 10 Other (specify) _____

SCREEN-PERFORATED INTERVALS: From 13 ft. to 23 ft. From _____ ft. to _____ ft.
From _____ ft. to _____ ft. From _____ ft. to _____ ft.
GRAVEL PACK INTERVALS: From 11 ft. to 23 ft. From _____ ft. to _____ ft.
From _____ ft. to _____ ft. From _____ ft. to _____ ft.

6 GROUT MATERIAL: 1 Neat cement 2 Cement grout **(3 Bentonite)** 4 Other _____
Grout Intervals From 1 ft. to 11 ft. From _____ ft. to _____ ft. From _____ ft. to _____ ft.

What is the nearest source of possible contamination:
1 Septic tank 4 Lateral lines 7 Pit privy 10 Livestock pens 13 Insecticide Storage 16 Other (specify below)
2 Sewer lines 5 Cess pool 8 Sewage lagoon 11 Fuel storage 14 Abandoned water well
3 Watertight sewer lines 6 Seepage pit 9 Feedyard 12 Fertilizer storage 15 Oil well/ gas well
Direction from well? _____ How many feet? _____

FROM	TO	LITHOLOGIC LOG	FROM	TO	PLUGGING INTERVALS
0	6"	Top soil, clay, silty			
6"	23	Clay, silty			
					MW 8

7 CONTRACTOR'S OR LANDOWNER'S CERTIFICATION: This water well was **(1) constructed**, (2) reconstructed, or (3) plugged under my jurisdiction and was completed on (mo/day/year) 04/23/2008 and this record is true to the best of my knowledge and belief. Kansas Water Well Contractor's License No. 594. This Water Well Record was completed on (mo/day/year) 05/16/2008 under the business name of Coranco Great Plains, Inc. by (signature) *Robert Hill*

INSTRUCTIONS: Please fill in blanks or circle the correct answers. Send top three copies to Kansas Department of Health and Environment, Bureau of Water, Geology Section, 1000 SW Jackson St., Suite 420, Topeka, Kansas 66612-1367. Telephone 785-296-5522. Send one to WATER WELL OWNER and retain one for your records. Fee of \$5.00 for each constructed well. Visit us at <http://www.kdheks.gov/waterwell>.