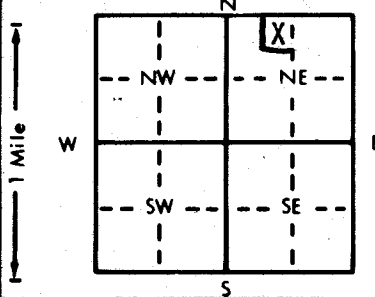


1 LOCATION OF WATER WELL: County: **Barber** Fraction: **NE 1/4 NW 1/4 NE 1/4** Section Number: **11** Township Number: **T 32 S** Range Number: **R 12 E**

Distance and direction from nearest town or city street address of well if located within city?
Approx. 1/2 mile west of U. S. Hwy. 281 & 3/4 mile north of U. S. Hwy. 160

2 WATER WELL OWNER: **Southern Wellpoint Co., Inc.**
 RR#, St. Address, Box #: **2935 North Toledo** Board of Agriculture, Division of Water Resources
 City, State, ZIP Code: **Tulsa, OK 74115** Application Number: **28460 35940**

3 LOCATE WELL'S LOCATION WITH AN "X" IN SECTION BOX:

 4 DEPTH OF COMPLETED WELL: **25 & 13** ft. ELEVATION: **1437**
 Depth(s) Groundwater Encountered: **1 Elev. 1450** ft. 2. ft. 3. ft.
 WELL'S STATIC WATER LEVEL: **Elev. 1460** ft. below land surface measured on mo/day/yr **12/21/81**
 Pump test data: Well water was _____ ft. after _____ hours pumping _____ gpm
 Est. Yield _____ gpm: Well water was _____ ft. after _____ hours pumping _____ gpm
 Bore Hole Diameter: _____ in. to _____ ft., and _____ in. to _____ ft.
 WELL WATER TO BE USED AS:
 1 Domestic 3 Feedlot 6 Oil field water supply 9 **Dewatering** 12 Other (Specify below)
 2 Irrigation 4 Industrial 7 Lawn and garden only 10 Observation well
 Was a chemical/bacteriological sample submitted to Department? Yes _____ No **X** _____; If yes, mo/day/yr sample was submitted _____
 Water Well Disinfected? Yes _____ No **X** _____

5 TYPE OF BLANK CASING USED:
 1 Steel 3 RMP (SR) 5 Wrought iron 8 Concrete tile CASING JOINTS: Glued **X** Clamped _____
 2 **PVC** 4 ABS 6 Asbestos-Cement 9 Other (specify below) Welded _____
 7 Fiberglass Threaded _____
 Blank casing diameter: **1 1/2** in. to **Elev. 1437** ft., Dia. _____ in. to _____ ft., Dia. _____ in. to _____ ft.
 Casing height above land surface: **12** in., weight **0.5** lbs./ft. Wall thickness or gauge No. **0.125"**
 TYPE OF SCREEN OR PERFORATION MATERIAL:
 1 Steel 3 Stainless steel 5 Fiberglass 8 RMP (SR) 10 Asbestos-cement 11 Other (specify) _____
 2 Brass 4 Galvanized steel 6 Concrete tile 9 ABS 12 None used (open hole)
 SCREEN OR PERFORATION OPENINGS ARE:
 1 Continuous slot 3 Mill slot 5 Gauzed wrapped 8 **Saw cut** 11 None (open hole)
 2 Louvered shutter 4 Key punched 6 Wire wrapped 9 Drilled holes
 7 Torch cut 10 Other (specify) _____
 SCREEN-PERFORATED INTERVALS: From **Elev. 1439** ft. to **Elev. 1437** ft., From _____ ft. to _____ ft.
 GRAVEL PACK INTERVALS: From **Elev. 1450** ft. to **Elev. 1437** ft., From _____ ft. to _____ ft.

6 GROUT MATERIAL: 1 Neat cement 2 Cement grout 3 Bentonite 4 Other _____
 Grout Intervals: From _____ ft. to _____ ft., From _____ ft. to _____ ft., From _____ ft. to _____ ft.
 What is the nearest source of possible contamination:
 1 Septic tank 4 Lateral lines 7 Pit privy 10 Livestock pens 14 Abandoned water well
 2 Sewer lines 5 Cess pool 8 Sewage lagoon 11 Fuel storage 15 Oil well/Gas well
 3 Watertight sewer lines 6 Seepage pit 9 Feedyard 12 Fertilizer storage 16 Other (specify below)
 13 Insecticide storage _____
 Direction from well? _____ How many feet? _____

FROM	TO	LITHOLOGIC LOG	FROM	TO	LITHOLOGIC LOG
		Stage I (upper) Installed at Elevation 1462			Stage II (lower) Installed at Elevation 1450
0	2	Sandy & Clayey silt w/rubble (fill)	0	8	Clayey Sand to Clay-sand (SC)
2	12	Sandy clay (CL)	8	13	Medium to Fine Sand (SP)
12	20	Clayey sand to clay-sand (SC)	13		Overconsolidated Red Clay
20	25	Medium to Fine Sand (SP)			
25		Overconsolidated Red Clay			

7 CONTRACTOR'S OR LANDOWNER'S CERTIFICATION: This water well was (1) constructed, (2) reconstructed, or (3) plugged under my jurisdiction and was completed on (mo/day/year) **3/12/82** and this record is true to the best of my knowledge and belief. Kansas Water Well Contractor's License No. **235** This Water Well Record was completed on (mo/day/yr) **7/9/82**
 under the business name of **Southern Wellpoint Co., Inc.** by (signature) *Randy L. Brou*
 INSTRUCTIONS: Use typewriter or ball point pen, PLEASE PRESS FIRMLY and PRINT clearly. Please fill in blanks, underline or circle the correct answers. Send top three copies to Kansas Department of Health and Environment, Division of Environment, Environmental Geology Section, Topeka, KS 66620. Send one to WATER WELL OWNER and retain one for your records.