

CORRECTION(S) TO WATER WELL RECORD (WWC-5)

(to rectify lacking or incorrect information)

County: Banben

Location listed as:

Section-Township-Range: 12-12-32w, Logan Co.

Fraction ($\frac{1}{4}$ $\frac{1}{4}$ $\frac{1}{4}$): _____

Location changed to:

12-32s-12w

Other changes: Initial statements: _____

T-R-S out of order. Clearly in
Medicine Lodge, so not sure how they got county wrong.

Changed to: _____

Comments: _____

verification method: _____

initials: _____ date: _____


submitted by: Kansas Geological Survey, Data Resources Library, 1930 Constant Ave., Lawrence, KS 66047-3726
to: Kansas Dept of Health & Environment, Bureau of Water, 1000 SW Jackson, Suite 420, Topeka, KS 66612-1367.

1 LOCATION OF WATER WELL: Fraction SE 1/4 NE 1/4 SW 1/4 Section Number 12 Township Number T 12 S Range Number R 32 EW
 County: LOGAN

Distance and direction from nearest town or city street address of well if located within city?
107 WEST FOWLER MEDICINE LODGE

2 WATER WELL OWNER: CLARKE CORP.
 RR#, St. Address, Box #: 107 WEST FOWLER Board of Agriculture, Division of Water Resources
 City, State, ZIP Code: MEDICINE LODGE KS 67104 Application Number:

3 LOCATE WELL'S LOCATION WITH AN "X" IN SECTION BOX:

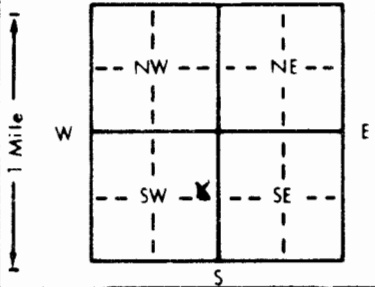

4 DEPTH OF COMPLETED WELL: 15.3 ft. ELEVATION:
 Depth(s) Groundwater Encountered 1. 6 ft. 2. - ft. 3. - ft.
 WELL'S STATIC WATER LEVEL: 6.63 ft. below land surface measured on mo/day/yr 06-14-94
 Pump test data: Well water was - ft. after - hours pumping - gpm
 Est. Yield - gpm: Well water was - ft. after - hours pumping - gpm
 Bore Hole Diameter: 8.625 in. to 15.3 ft. and - in. to - ft.
 WELL WATER TO BE USED AS:
 5 Public water supply 8 Air conditioning 11 Injection well
 1 Domestic 3 Feedlot 6 Oil field water supply 9 Dewatering 12 Other (Specify below)
 2 Irrigation 4 Industrial 7 Lawn and garden only 10 Monitoring well
 Was a chemical/bacteriological sample submitted to Department? Yes - No X; If yes, mo/day/yr sample was submitted
 Water Well Disinfected? Yes - No X

5 TYPE OF BLANK CASING USED:
 1 Steel 3 RMP (SR) 5 Wrought iron 8 Concrete tile CASING JOINTS: Glued - Clamped -
2 PVC 4 ABS 6 Asbestos-Cement 9 Other (specify below) Welded -
 7 Fiberglass Threaded X
 Blank casing diameter: 2 in. to 5 ft. Dia. - in. to - ft. Dia. - in. to - ft.
 Casing height above land surface: 24 in. weight 5CH 40 lbs./ft. Wall thickness or gauge No. -

TYPE OF SCREEN OR PERFORATION MATERIAL:
 1 Steel 3 Stainless steel 5 Fiberglass 7 PVC 10 Asbestos-cement
 2 Brass 4 Galvanized steel 6 Concrete tile 8 RMP (SR) 11 Other (specify) -
 9 ABS 12 None used (open hole)

SCREEN OR PERFORATION OPENINGS ARE:
 1 Continuous slot 3 Mill slot 5 Gauzed wrapped 8 Saw cut 11 None (open hole)
 2 Louvered shutter 4 Key punched 6 Wire wrapped 9 Drilled holes
 7 Torch cut 10 Other (specify) -

SCREEN-PERFORATED INTERVALS: From 5 ft. to 15 ft. From - ft. to - ft.
 From - ft. to - ft. From - ft. to - ft.
 SAND GRAVEL PACK INTERVALS: From 4 ft. to 15.3 ft. From - ft. to - ft.
 From - ft. to - ft. From - ft. to - ft.

6 GROUT MATERIAL: 1 Neat cement 2 Cement grout 3 Bentonite 4 Other
 Grout intervals: From 01 ft. to 2 ft. From 2 ft. to 4 ft. From - ft. to - ft.

What is the nearest source of possible contamination:
 1 Septic tank 4 Lateral lines 7 Pit privy 10 Livestock pens 14 Abandoned water well
 2 Sewer lines 5 Cess pool 8 Sewage lagoon 11 Fuel storage 15 Oil well/Gas well
 3 Watertight sewer lines 6 Seepage pit 9 Feedyard 12 Fertilizer storage 16 Other (specify below)
 13 Insecticide storage CONTAMINATED SITE
 Direction from well? - How many feet? -

FROM	TO	LITHOLOGIC LOG	FROM	TO	PLUGGING INTERVALS
<u>01</u>	<u>15</u>	<u>FILL GRAVEL</u>			
<u>15</u>	<u>4</u>	<u>SILTY SAND</u>			
<u>4</u>	<u>6</u>	<u>CLAY SILT</u>			
<u>6</u>	<u>15.3</u>	<u>SILTY-SAND GRAVEL</u>			
<u>TD</u>	<u>15.3</u>				

7 CONTRACTOR'S OR LANDOWNER'S CERTIFICATION: This water well was (1) constructed (2) reconstructed, or (3) plugged under my jurisdiction and was completed on (mo/day/year) 06-13-94 and this record is true to the best of my knowledge and belief. Kansas Water Well Contractor's License No. 479 This Water Well Record was completed on (mo/day/yr) 06-30-94 under the business name of EBBERTS DRILLING by (signature) [Signature]