

CORRECTION(S) TO WATER WELL RECORD (WWC-5)

(to rectify lacking or incorrect information)

County: Banben

Location listed as:

Section-Township-Range: 12-12-32w, Logan Co.

Fraction ($\frac{1}{4}$ $\frac{1}{4}$ $\frac{1}{4}$): _____

Location changed to:

12-32s-12w

Other changes: Initial statements: _____

T-R-S out of order. Clearly in
Medicine Lodge, so not sure how they got county wrong.

Changed to: _____

Comments: _____

verification method: _____


initials: _____ date: _____

submitted by: Kansas Geological Survey, Data Resources Library, 1930 Constant Ave., Lawrence, KS 66047-3726
to: Kansas Dept of Health & Environment, Bureau of Water, 1000 SW Jackson, Suite 420, Topeka, KS 66612-1367.

1 LOCATION OF WATER WELL: County: **LDGAN** Fraction: **NW 1/4 NE 1/4 SW 1/4** Section Number: **12** Township Number: **T 12 S** Range Number: **R 32 EW**

Distance and direction from nearest town or city street address of well if located within city?
E. CHERRY ST S - HWY 60 MEDICINE LODGE KS

2 WATER WELL OWNER: **CITY OF MEDICINE LODGE**
 RR#, St. Address, Box #: **ATT: KENNETH SWIGGART** Board of Agriculture, Division of Water Resources
 City, State, ZIP Code: **MEDICINE LODGE KS 67104** Application Number:

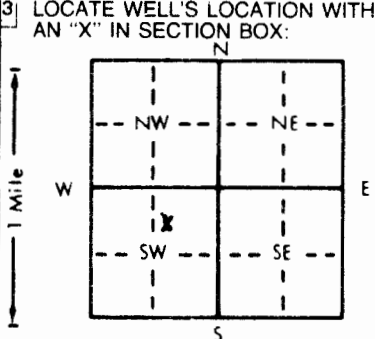

4 DEPTH OF COMPLETED WELL: **15.3** ft. ELEVATION:
 Depth(s) Groundwater Encountered 1. **5** ft. 2. **-** ft. 3. **-** ft.
 WELL'S STATIC WATER LEVEL: **10.11** ft. below land surface measured on mo/day/yr **06-14-94**
 Pump test data: Well water was **-** ft. after **-** hours pumping **-** gpm
 Est. Yield **-** gpm: Well water was **-** ft. after **-** hours pumping **-** gpm
 Bore Hole Diameter: **8.625** in. to **15.3** ft. and **-** in. to **-** ft.
 WELL WATER TO BE USED AS:
 5 Public water supply 8 Air conditioning 11 Injection well
 1 Domestic 3 Feedlot 6 Oil field water supply 9 Dewatering 12 Other (Specify below)
 2 Irrigation 4 Industrial 7 Lawn and garden only **10 Monitoring well**
 Was a chemical/bacteriological sample submitted to Department? Yes **-** No **X**; If yes, mo/day/yr sample was submitted
 Water Well Disinfected? Yes **-** No **X**

5 TYPE OF BLANK CASING USED:
 1 Steel 3 RMP (SR) 5 Wrought iron 8 Concrete tile CASING JOINTS: Glued **-** Clamped **-**
2 PVC 4 ABS 6 Asbestos-Cement 9 Other (specify below) Welded **-**
 7 Fiberglass Threaded **X**
 Blank casing diameter: **2** in. to **5** ft. Dia. **-** in. to **-** ft. Dia. **-** in. to **-** ft.
 Casing height above land surface: **FLUSH 0** in. weight **SCH 40** lbs./ft. Wall thickness or gauge No. **-**

TYPE OF SCREEN OR PERFORATION MATERIAL:
 1 Steel 3 Stainless steel 5 Fiberglass 7 **PVC** 10 Asbestos-cement
 2 Brass 4 Galvanized steel 6 Concrete tile 8 RMP (SR) 11 Other (specify) **-**
 9 ABS 12 None used (open hole)

SCREEN OR PERFORATION OPENINGS ARE:
 1 Continuous slot 3 **Mill slot** 5 Gauzed wrapped 8 Saw cut 11 None (open hole)
 2 Louvered shutter 4 Key punched 6 Wire wrapped 9 Drilled holes
 7 Torch cut 10 Other (specify) **-**

SCREEN-PERFORATED INTERVALS: From **5** ft. to **15** ft. From **-** ft. to **-** ft.
SAND From **-** ft. to **-** ft. From **-** ft. to **-** ft.
GRAVEL PACK INTERVALS: From **4** ft. to **15.3** ft. From **-** ft. to **-** ft.
 From **-** ft. to **-** ft. From **-** ft. to **-** ft.

6 GROUT MATERIAL: 1 Neat cement 2 **Cement grout** 3 **Bentonite** 4 Other **-**
 Grout Intervals: From **GL** ft. to **2** ft. From **2** ft. to **4** ft. From **-** ft. to **-** ft.
 What is the nearest source of possible contamination:
 1 Septic tank 4 Lateral lines 7 Pit privy 10 Livestock pens 14 Abandoned water well
 2 Sewer lines 5 Cess pool 8 Sewage lagoon 11 **Fuel storage** 15 Oil well/Gas well
 3 Watertight sewer lines 6 Seepage pit 9 Feedyard 12 Fertilizer storage 16 Other (specify below) **CONTAMINATED SITE**
 13 Insecticide storage How many feet? **-**

FROM	TO	LITHOLOGIC LOG	FROM	TO	PLUGGING INTERVALS
GL	2	SOIL - SILTY SAND			
2	5	CLAY SILT			
5	15.3	SILTY SAND			
TD	15.3				

7 CONTRACTOR'S OR LANDOWNER'S CERTIFICATION: This water well was **(1) constructed**, (2) reconstructed, or (3) plugged under my jurisdiction and was completed on (mo/day/year) **06-14-94** and this record is true to the best of my knowledge and belief. Kansas Water Well Contractor's License No. **479** This Water Well Record was completed on (mo/day/yr) **06-30-94** under the business name of **EBBERTS DRILLING** by (signature) *Rugan Elbert*

OFFICE USE ONLY
T
R
EW
SEC.