

**CORRECTION(S) TO WATER WELL RECORD (WWC-5)**

(to rectify lacking or incorrect information)

County: Banben

**Location listed as:**

Section-Township-Range: 12-12-32w, Logan Co.

Fraction (  $\frac{1}{4}$   $\frac{1}{4}$   $\frac{1}{4}$ ): \_\_\_\_\_

**Location changed to:**

12-32s-12w

**Other changes:** Initial statements: \_\_\_\_\_

T-R-S out of order. Clearly in  
Medicine Lodge, so not sure how they got county wrong.

Changed to: \_\_\_\_\_

Comments: \_\_\_\_\_


verification method: \_\_\_\_\_

initials: \_\_\_\_\_ date: \_\_\_\_\_

submitted by: Kansas Geological Survey, Data Resources Library, 1930 Constant Ave., Lawrence, KS 66047-3726  
to: Kansas Dept of Health & Environment, Bureau of Water, 1000 SW Jackson, Suite 420, Topeka, KS 66612-1367.

1 LOCATION OF WATER WELL: Fraction NE 1/4 NE 1/4 SW 1/4 Section Number 72 Township Number T 12 S Range Number R 32 E/W  
 County: LOGAN  
 Distance and direction from nearest town or city street address of well if located within city?  
107 WEST FOWLER - MEDICINE LODGE

2 WATER WELL OWNER: CLARKE CORP  
 RR#, St. Address, Box #: 107 WEST FOWLER  
 City, State, ZIP Code: MEDICINE LODGE KS - 67104  
 Board of Agriculture, Division of Water Resources  
 Application Number:

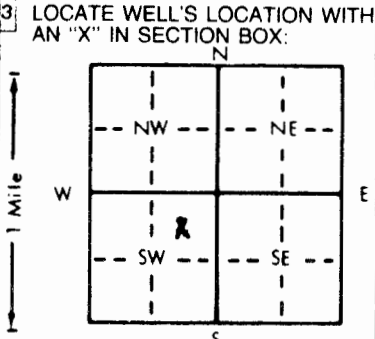

4 DEPTH OF COMPLETED WELL: 15.3 ft. ELEVATION:  
 Depth(s) Groundwater Encountered 1. 4.8 ft. 2. - ft. 3. - ft.  
 WELL'S STATIC WATER LEVEL 4.31 ft. below land surface measured on mo/day/yr 06-14-94  
 Pump test data: Well water was - ft. after - hours pumping - gpm  
 Est. Yield - gpm: Well water was - ft. after - hours pumping - gpm  
 Bore Hole Diameter: 8.625 in. to 15.3 ft. and - in. to - ft.  
 WELL WATER TO BE USED AS:  
 5 Public water supply 8 Air conditioning 11 Injection well  
 1 Domestic 3 Feedlot 6 Oil field water supply 9 Dewatering 12 Other (Specify below)  
 2 Irrigation 4 Industrial 7 Lawn and garden only 10 Monitoring well  
 Was a chemical/bacteriological sample submitted to Department? Yes - No X; If yes, mo/day/yr sample was submitted  
 Water Well Disinfected? Yes - No X

5 TYPE OF CASING USED:  
 1 Steel 3 RMP (SR) 5 Wrought iron 8 Concrete tile CASING JOINTS: Glued - Clamped -  
 2 PVC 4 ABS 6 Asbestos-Cement 9 Other (specify below) Welded -  
 7 Fiberglass Threaded X  
 Blank casing diameter 2 in. to 5 ft. Dia - in. to - ft. Dia - in. to - ft.  
 Casing height above land surface 24 in. weight 34 40 lbs./ft. Wall thickness or gauge No. -

TYPE OF SCREEN OR PERFORATION MATERIAL:  
 1 Steel 3 Stainless steel 5 Fiberglass 7 PVC 10 Asbestos-cement  
 2 Brass 4 Galvanized steel 6 Concrete tile 8 RMP (SR) 11 Other (specify) -  
 9 ABS 12 None used (open hole)

SCREEN OR PERFORATION OPENINGS ARE:  
 1 Continuous slot 3 Mill slot 5 Gauzed wrapped 8 Saw cut 11 None (open hole)  
 2 Louvered shutter 4 Key punched 6 Wire wrapped 9 Drilled holes  
 7 Torch cut 10 Other (specify) -

SCREEN-PERFORATED INTERVALS: From 5 ft. to 15 ft. From - ft. to - ft.  
~~SAND~~ From - ft. to - ft. From - ft. to - ft.  
~~GRAVEL~~ PACK INTERVALS: From 4 ft. to 15.3 ft. From - ft. to - ft.  
 From - ft. to - ft. From - ft. to - ft.

6 GROUT MATERIAL: 1 Neat cement 2 Cement grout 3 Bentonite 4 Other -  
 Grout Intervals: From GL ft. to 2 ft. From 2 ft. to 4 ft. From - ft. to - ft.

What is the nearest source of possible contamination:  
 1 Septic tank 4 Lateral lines 7 Pit privy 10 Livestock pens 14 Abandoned water well  
 2 Sewer lines 5 Cess pool 8 Sewage lagoon 11 Fuel storage 15 Oil well/Gas well  
 3 Watertight sewer lines 6 Seepage pit 9 Feedyard 12 Fertilizer storage 16 Other (specify below) CONTAMINATED SITE  
 13 Insecticide storage

Direction from well? - How many feet? -

FROM	TO	LITHOLOGIC LOG	FROM	TO	PLUGGING INTERVALS
<u>GL</u>	<u>1</u>	<u>FILL - SD + GRL</u>			
<u>1</u>	<u>15.3</u>	<u>SILTY SAND</u>			
<u>TD</u>	<u>15.3</u>				

7 CONTRACTOR'S OR LANDOWNER'S CERTIFICATION: This water well was (1) constructed, (2) reconstructed, or (3) plugged under my jurisdiction and was completed on (mo/day/year) 06-14-94 and this record is true to the best of my knowledge and belief. Kansas Water Well Contractor's License No. 479 This Water Well Record was completed on (mo/day/yr) 06-14-94 under the business name of EBBERTS DRILLING by (signature) Gregg Ebberts

OFFICE USE ONLY

T

R

EW

SEC.

1/4

1/4

1/4