


BH 2 / MW #1

1 LOCATION OF WATER WELL: County: <u>Barber</u>	Fraction <u>SE 1/4 SE 1/4 NW 1/4</u>	Section Number <u>12</u>	Township Number T <u>32</u> S	Range Number R <u>12W</u> EW
--	---	-----------------------------	----------------------------------	---------------------------------

Distance and direction from nearest town or city street address of well if located within city?
414 S. Main Medicine Lodge KS

2 WATER WELL OWNER: RR#, St. Address, Box # : City, State, ZIP Code	<u>Serry Bryan</u> <u>414 S. Main</u> <u>Medicine Lodge KS 67104</u>	Board of Agriculture, Division of Water Resources Application Number:
---	--	--

3 LOCATE WELL'S LOCATION WITH AN "X" IN SECTION BOX:

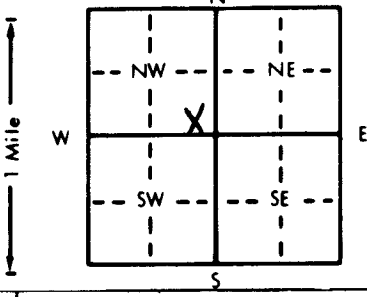

4 DEPTH OF COMPLETED WELL: 15' ft. ELEVATION:

Depth(s) Groundwater Encountered 1. 9.5' ft. 2. ft. 3. ft.

WELL'S STATIC WATER LEVEL 7.87' ft. below land surface measured on mo/day/yr 5-7-91

Pump test data: Well water was ft. after hours pumping gpm

Est. Yield gpm; Well water was ft. after hours pumping gpm

Bore Hole Diameter: 8" in. to ft., and in. to ft.

WELL WATER TO BE USED AS:

5 Public water supply	8 Air conditioning	11 Injection well
1 Domestic	3 Feedlot	6 Oil field water supply
2 Irrigation	4 Industrial	7 Lawn and garden only
		<u>10 Monitoring well</u>
		12 Other (Specify below)

Was a chemical/bacteriological sample submitted to Department? Yes No XX; If yes, mo/day/yr sample was submitted

Water Well Disinfected? Yes No XX

5 TYPE OF BLANK CASING USED:

1 Steel	3 RMP (SR)	6 Asbestos-Cement	9 Other (specify below)	CASING JOINTS: Glued Clamped
<u>2 PVC</u>	4 ABS	7 Fiberglass		Welded
				Threaded: <u>Flush Joint</u>

Blank casing diameter 2" in. to ft., Dia. in. to ft., Dia. in. to ft.

Casing height above land surface in., weight .703 lbs./ft. Wall thickness or gauge No. .154

TYPE OF SCREEN OR PERFORATION MATERIAL:

1 Steel	3 Stainless steel	5 Fiberglass	8 RMP (SR)	10 Asbestos-cement
2 Brass	4 Galvanized steel	6 Concrete tile	9 ABS	11 Other (specify)
				12 None used (open hole)

SCREEN OR PERFORATION OPENINGS ARE:

1 Continuous slot	<u>3 Mill slot</u>	5 Gauzed wrapped	8 Saw cut	11 None (open hole)
2 Louvered shutter	4 Key punched	6 Wire wrapped	9 Drilled holes	
		7 Torch cut	10 Other (specify)	

SCREEN-PERFORATED INTERVALS: From 4.5' ft. to 14.5' ft., From ft. to ft.

GRAVEL PACK INTERVALS: From 2.5' ft. to 14.5' ft., From ft. to ft.

6 GROUT MATERIAL: 1 Neat cement 2 Cement grout 3 Bentonite 4 Other

Grout intervals: From 5' ft. to 2.5' ft., From ft. to ft., From ft. to ft.

What is the nearest source of possible contamination:

1 Septic tank	4 Lateral lines	7 Pit privy	<u>11 Fuel storage</u>	14 Abandoned water well
2 Sewer lines	5 Cess pool	8 Sewage lagoon	12 Fertilizer storage	15 Oil well/Gas well
3 Watertight sewer lines	6 Seepage pit	9 Feedyard	13 Insecticide storage	16 Other (specify below)

Direction from well? South How many feet? 5'

FROM	TO	LITHOLOGIC LOG	FROM	TO	PLUGGING INTERVALS
0	8"	Concrete - Sand			
8"	3.5'	lean clay w/ sand			
3.5'	9.0'	Sandy Clay			
9.0'	10.0'	Clay			
10.0'	15.0'	Shale			

7 CONTRACTOR'S OR LANDOWNER'S CERTIFICATION: This water well was (1) constructed, (2) reconstructed, or (3) plugged under my jurisdiction and was completed on (mo/day/year) 04-29-91 and this record is true to the best of my knowledge and belief. Kansas Water Well Contractor's License No. 531 This Water Well Record was completed on (mo/day/yr) 05-13-91 under the business name of Geotechnical Services, Inc. by (signature) Allison Bassett