


1 LOCATION OF WATER WELL: County: Barber Fraction: se 1/4 se 1/4 SW 1/4 Section Number: 13 Township Number: T 32 S Range Number: R 12 EAW

Distance and direction from nearest town or city street address of well if located within city?
1 mile south (Medicine Lodge)

2 WATER WELL OWNER: Theron Krehbiel Board of Agriculture, Division of Water Resources
 RR#, St. Address, Box #: R1 Application Number:
 City, State, ZIP Code: Medicine Lodge, Kan. 67104

3 LOCATE WELL'S LOCATION WITH AN "X" IN SECTION BOX:

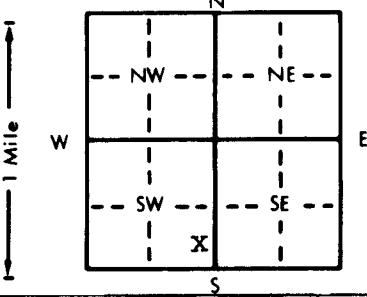

4 DEPTH OF COMPLETED WELL: 55.5 ft. ELEVATION:
 Depth(s) Groundwater Encountered 1. 4 ft. 2. 55.5 ft. 3. 1-31-84 ft.
 WELL'S STATIC WATER LEVEL 4 ft. below land surface measured on mo/day/yr
 Bore Hole Diameter: 9 in. to 55 ft., and 9 in. to 55 ft.
 WELL WATER TO BE USED AS:
 1 Domestic 1 3 Feedlot 3 6 Oil field water supply 6 9 Dewatering 9 11 Injection well 11
 2 Irrigation 2 4 Industrial 4 7 Lawn and garden only 7 10 Observation well 10
 Was a chemical/bacteriological sample submitted to Department? Yes No No No; If yes, mo/day/yr sample was submitted
 Water Well Disinfected? Yes No No No

5 TYPE OF CASING USED:
 1 Steel 5 3 RMP (SR) 3 6 Asbestos-Cement 6 9 Other (specify below) 9
 2 PVC 2 4 ABS 4 7 Fiberglass 7 CASING JOINTS: Glued Clamped Clamped
 Welded Welded
 Threaded Threaded

 Casing height above land surface 18 in., weight 18 lbs./ft. Wall thickness or gauge No. 265

TYPE OF SCREEN OR PERFORATION MATERIAL:
 1 Steel 7 3 Stainless steel 3 5 Fiberglass 5 8 RMP (SR) 8 10 Asbestos-cement 10
 2 Brass 2 4 Galvanized steel 4 6 Concrete tile 6 9 ABS 9 11 Other (specify) 11
 12 None used (open hole) 12

SCREEN OR PERFORATION OPENINGS ARE:
 1 Continuous slot 8 3 Mill slot 3 5 Gauzed wrapped 5 8 Saw cut 8 11 None (open hole) 11
 2 Louvered shutter 2 4 Key punched 4 6 Wire wrapped 6 9 Drilled holes 9
 7 Torch cut 7 10 Other (specify) 10


6 GROUT MATERIAL: 1 Neat cement 1 2 Cement grout 2 3 Bentonite 3 4 Other 4

What is the nearest source of possible contamination:
 1 Septic tank 1 4 Lateral lines 4 7 Pit privy 7 10 Livestock pens 10 14 Abandoned water well 14
 2 Sewer lines 2 5 Cess pool 5 8 Sewage lagoon 8 11 Fuel storage 11 15 Oil well/Gas well 15
 3 Watertight sewer lines 3 6 ~~Septic~~ pit 6 9 Feedyard 9 12 Fertilizer storage 12 16 Other (specify below) 16
 13 Insecticide storage 13
 Direction from well? S How many feet? 100

FROM	TO	LITHOLOGIC LOG	FROM	TO	LITHOLOGIC LOG
0	3	soil			
3	22	medium sand			
22	44	fine sand and silt			
44	55	medium sand, some coarse			

7 CONTRACTOR'S OR LANDOWNER'S CERTIFICATION: This water well was (1) constructed, (2) reconstructed, or (3) plugged under my jurisdiction and was completed on (mo/day/year) 1-31-84 and this record is true to the best of my knowledge and belief. Kansas Water Well Contractor's License No. 140 This Water Well Record was completed on (mo/day/yr) 2-1-84 under the business name of Luman Bros. by (signature) Richard Luman

INSTRUCTIONS: Use typewriter or ball point pen, PLEASE PRESS FIRMLY and PRINT clearly. Please fill in blanks, underline or circle the correct answers. Send top three copies to Kansas Department of Health and Environment, Division of Environment, Environmental Geology Section, Topeka, KS 66620. Send one to WATER WELL OWNER and retain one for your records.

OFFICE USE ONLY
T
M
R
1
2
EAW
SEC.
13
SE 1/4
SE 1/4
SW 1/4