


1 LOCATION OF WATER WELL: County: Barber Fraction: SW 1/4 NW 1/4 SE 1/4 Section Number: 23 Township Number: T 32 S Range Number: R 13 E/W

Distance and direction from nearest town or city street address of well if located within city?
7W 35 Medicine Lodge, KS

2 WATER WELL OWNER: Binning Partnership Box 248 Medicine Lodge, KS 67104
 RR#, St. Address, Box #: Box 248 Board of Agriculture, Division of Water Resources
 City, State, ZIP Code: Medicine Lodge, KS 67104 Application Number:

3 LOCATE WELL'S LOCATION WITH AN "X" IN SECTION BOX: 4 DEPTH OF COMPLETED WELL: 62 ft. ELEVATION: 430.05

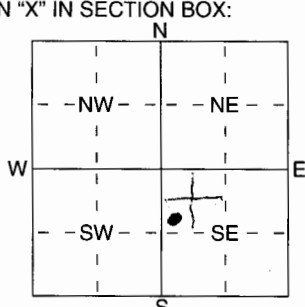

Depth(s) Groundwater Encountered: 1 ft. 2 _____ ft. 3 _____ ft.
 WELL'S STATIC WATER LEVEL: 7 ft. below land surface measured on mo/day/yr 4-30-05
 Pump test data: Well water was _____ ft. after _____ hours pumping _____ gpm
 Est. Yield _____ gpm: Well water was _____ ft. after _____ hours pumping _____ gpm
 WELL WATER TO BE USED AS:
 1 Domestic 3 Feedlot 6 Oil field water supply 9 Dewatering 12 Other (Specify below)
 2 Irrigation 4 Industrial 7 Domestic (lawn & garden) 10 Monitoring well

Was a chemical/bacteriological sample submitted to Department? Yes _____ No X; If yes, mo/day/yr sample was submitted
 Water Well Disinfected? Yes X No _____

5 TYPE OF BLANK CASING USED:
 1 Steel 3 RMP (SR) 5 Wrought iron 8 Concrete tile CASING JOINTS: Glued X Clamped _____
 2 PVC 4 ABS 6 Asbestos-Cement 9 Other (specify below) Welded _____
 7 Fiberglass Threaded _____

Blank casing diameter: 5 in. to 20 ft., Dia _____ in. to _____ ft., Dia _____ in. to _____ ft.
 Casing height above land surface: 30 in., weight 160# lbs./ft. Wall thickness or guage No. _____

TYPE OF SCREEN OR PERFORATION MATERIAL:
 1 Steel 3 Stainless Steel 5 Fiberglass 8 RMP (SR) 10 Asbestos-Cement
 2 Brass 4 Galvanized Steel 6 Concrete tile 9 ABS 11 Other (Specify) _____
 12 None used (open hole)

SCREEN OR PERFORATION OPENINGS ARE:
 1 Continuous slot 3 Mill slot 5 Gauzed wrapped 8 Saw cut 11 None (open hole)
 2 Louvered shutter 4 Key punched 6 Wire wrapped 9 Drilled holes
 7 Torch cut 10 Other (specify) _____ ft.

SCREEN-PERFORATED INTERVALS: From 20 ft. to 62 ft., From _____ ft. to _____ ft.
 From _____ ft. to _____ ft., From _____ ft. to _____ ft.
 GRAVEL PACK INTERVALS: From 20 ft. to 62 ft., From _____ ft. to _____ ft.
 From _____ ft. to _____ ft., From _____ ft. to _____ ft.

6 GROUT MATERIAL: 1 Neat cement 2 Cement grout 3 Bentonite 4 Other _____
 Grout Intervals: From 0 ft. to 20 ft., From _____ ft. to _____ ft., From _____ ft. to _____ ft.

What is the nearest source of possible contamination:
 1 Septic tank 4 Lateral lines 7 Pit privy 10 Livestock pens 14 Abandoned water well
 2 Sewer lines 5 Cess pool 8 Sewage lagoon 11 Fuel storage 15 Oil well/Gas well
 3 Watertight sewer lines 6 Seepage pit 9 Feedyard 12 Fertilizer storage 16 Other (specify below)
 13 Insecticide storage
 Direction from well? N How many feet? 200'

FROM	TO	LITHOLOGIC LOG	FROM	TO	PLUGGING INTERVALS
<u>0</u>	<u>3</u>	<u>Soil</u>			
<u>3</u>	<u>8</u>	<u>Dirty Sand</u>			
<u>8</u>	<u>22</u>	<u>Sand - washed in shale</u>	<u>Some big</u>		
<u>22</u>	<u>24</u>	<u>Big Silty Sand</u>			
<u>24</u>	<u>58</u>	<u>Dark Clay and silt</u>			
<u>58</u>	<u>62</u>	<u>Red Shale</u>			

7 CONTRACTOR'S OR LANDOWNER'S CERTIFICATION: This water well was (1) constructed, (2) reconstructed, or (3) plugged under my jurisdiction and was completed on (mo/day/year) 4-30-05 and this record is true to the best of my knowledge and belief. Kansas Water Well Contractor's Licence No 140 This Water Well Record was completed on (mo/day/yr) 5-24-05 under the business name of Lyman's Inc. by (signature) [Signature]