

**WATER WELL RECORD Form WWC-5**


Original Record  Correction  Change in Well Use

Division of Water Resources App. No.  

Well ID Well #4

**1 LOCATION OF WATER WELL:** County: Barber Fraction: SE 1/4 SE 1/4 NE 1/4 NW 1/4 Section Number: 19 Township Number: T 32 S Range Number: R 13 E W

**2 WELL OWNER:** Last Name: Nichols First: Max Street or Rural Address where well is located (if unknown, distance and direction from nearest town or intersection): If at owner's address, check here:   
 Business: Nichols Ranch Co. Address: Po Box 515 City: Great Bend State: KS ZIP: 67530  
3279' North, 3677' East

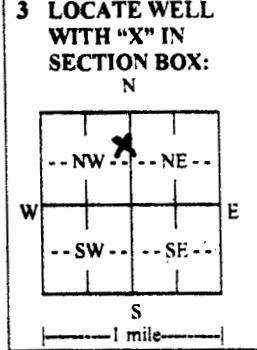

**4 DEPTH OF COMPLETED WELL:** 70 ft.  
 Depth(s) Groundwater Encountered: 1) 10 ft. 2)   ft. 3)   ft., or 4)  Dry Well  
**WELL'S STATIC WATER LEVEL:** 10 ft.  
 below land surface, measured on (mo-day-yr) 09-08-2009  
 above land surface, measured on (mo-day-yr)    
 Pump test data: Well water was   ft. after   hours pumping   gpm  
 Well water was   ft. after   hours pumping   gpm  
 Estimated Yield: 15 gpm  
 Bore Hole Diameter: 10.25 in. to 70 ft. and   in. to   ft.

**5 Latitude:** 37.250473 (decimal degrees)  
**Longitude:** 98.777010 (decimal degrees)  
 Horizontal Datum:  WGS 84  NAD 83  NAD 27  
 Source for Latitude/Longitude:  
 GPS (unit make/model:  ) (WAAS enabled?  Yes  No)  
 Land Survey  Topographic Map  
 Online Mapper:    
**6 Elevation:** 1741 ft.  Ground Level  TOC  
 Source:  Land Survey  GPS  Topographic Map  
 Other: Kolar

**7 WELL WATER TO BE USED AS:**

1. Domestic: <input type="checkbox"/> Household <input type="checkbox"/> Lawn & Garden <input checked="" type="checkbox"/> Livestock	2. <input type="checkbox"/> Irrigation	3. <input type="checkbox"/> Feedlot	4. <input type="checkbox"/> Industrial	5. <input type="checkbox"/> Public Water Supply: well ID <u> </u>	6. <input type="checkbox"/> Dewatering: how many wells? <u> </u>	7. <input type="checkbox"/> Aquifer Recharge: well ID <u> </u>	8. <input type="checkbox"/> Monitoring: well ID <u> </u>	9. Environmental Remediation: well ID <u> </u> <input type="checkbox"/> Air Sparge <input type="checkbox"/> Soil Vapor Extraction <input type="checkbox"/> Recovery <input type="checkbox"/> Injection	10. <input type="checkbox"/> Oil Field Water Supply: lease <u> </u>	11. Test Hole: well ID <u> </u> <input type="checkbox"/> Cased <input type="checkbox"/> Uncased <input type="checkbox"/> Geotechnical	12. Geothermal: how many bores? <u> </u> a) Closed Loop <input type="checkbox"/> Horizontal <input type="checkbox"/> Vertical b) Open Loop <input type="checkbox"/> Surface Discharge <input type="checkbox"/> Inj. of Water	13. <input type="checkbox"/> Other (specify): <u> </u>
---	----------------------------------------	-------------------------------------	----------------------------------------	-------------------------------------------------------------------	------------------------------------------------------------------	----------------------------------------------------------------	----------------------------------------------------------	---	---------------------------------------------------------------------	---	---	--------------------------------------------------------

Was a chemical/bacteriological sample submitted to KDHE?  Yes  No If yes, date sample was submitted:    
 Water well disinfected?  Yes  No

**8 TYPE OF CASING USED:**  Steel  PVC  Other   CASING JOINTS:  Glued  Clamped  Welded  Threaded  
 Casing diameter 6 in. to 70 ft., Diameter   in. to   ft., Diameter   in. to   ft.  
 Casing height above land surface 20 in. Weight   lbs./ft. Wall thickness or gauge No. SDR 21  
**TYPE OF SCREEN OR PERFORATION MATERIAL:**  
 Steel  Stainless Steel  Fiberglass  PVC  Other (Specify)    
 Brass  Galvanized Steel  Concrete tile  None used (open hole)  
**SCREEN OR PERFORATION OPENINGS ARE:**  
 Continuous Slot  Mill Slot  Gauze Wrapped  Torch Cut  Drilled Holes  Other (Specify)    
 Louvered Shutter  Key Punched  Wire Wrapped  Saw Cut  None (Open Hole)  
**SCREEN-PERFORATED INTERVALS:** From 10 ft. to 70 ft., From   ft. to   ft., From   ft. to   ft.  
**GRAVEL PACK INTERVALS:** From 10 ft. to 70 ft., From   ft. to   ft., From   ft. to   ft.

**9 GROUT MATERIAL:**  Neat cement  Cement grout  Bentonite  Other    
 Grout intervals: From 0 ft. to 10 ft., From   ft. to   ft., From   ft. to   ft.  
**Nearest source of possible contamination:**  
 Septic Tank  Lateral Lines  Pit Privy  Livestock Pens  Insecticide Storage  
 Sewer Lines  Cess Pool  Sewage Lagoon  Fuel Storage  Abandoned Water Well  
 Watertight Sewer Lines  Seepage Pit  Feedyard  Fertilizer Storage  Oil Well/Gas Well  
 Other (Specify)    
 Direction from well? South Distance from well? 25 ft.

10 FROM	TO	LITHOLOGIC LOG	FROM	TO	LITHO. LOG (cont.) or PLUGGING INTERVALS
0	10	Top Soil. Red Clay			
10	20	Rock layers. Red Clay shale			
		Gyp layers. Large smooth rock			
20	70	Rock layers. Red/Grey shale			

**11 CONTRACTOR'S OR LANDOWNER'S CERTIFICATION:** This water well was  constructed,  reconstructed, or  plugged under my jurisdiction and was completed on (mo-day-year) 09-08-2009 and this record is true to the best of my knowledge and belief.  
 Kansas Water Well Contractor's License No. 846 This Water Well Record was completed on (mo-day-year) 9-29-2009  
 under the business name of Nash Water Well Service, LLC Signature