

WATER WELL RECORD Form WWC-5


Original Record Correction Change in Well Use

Division of Water Resources App. No.

Well ID

1 LOCATION OF WATER WELL: County: Comanche Fraction: 1/4 SE 1/4 NE 1/4 SE 1/4 Section Number: 18 Township Number: T 32 S Range Number: R 17 E W

2 WELL OWNER: Last Name: Robert Dale Gray First: Kremin State: OK ZIP: 73753
 Business: 123 E. Keowee Rd. Street or Rural Address where well is located (if unknown, distance and direction from nearest town or intersection): 160 Hwy 1 & Rd. 191 South 1/4 East on Ave 3 South 1/4 SE
 Address: 123 E. Keowee Rd.
 City: Kremin

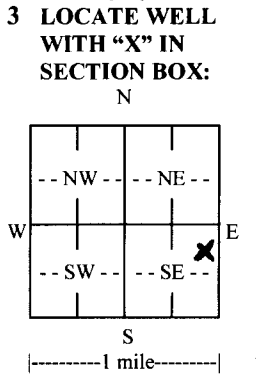

4 DEPTH OF COMPLETED WELL: 155 ft.
 Depth(s) Groundwater Encountered: 1) ft.
 2) ft. 3) ft., or 4) Dry Well
 WELL'S STATIC WATER LEVEL: 36 ft.
 below land surface, measured on (mo-day-yr).....
 above land surface, measured on (mo-day-yr) 6-28-13
 Pump test data: Well water was ft.
 after hours pumping gpm
 Well water was ft.
 after hours pumping gpm
 Estimated Yield: 100 gpm
 Bore Hole Diameter: 10 7/8 in. to 155 ft. and in. to ft.

5 Latitude: (decimal degrees)
Longitude: (decimal degrees)
 Datum: WGS 84 NAD 83 NAD 27
Source for Latitude/Longitude:
 GPS (unit make/model:)
 (WAAS enabled? Yes No)
 Land Survey Topographic Map
 Online Mapper:

6 Elevation: ft. Ground Level TOC
 Source: Land Survey GPS Topographic Map
 Other

7 WELL WATER TO BE USED AS:

1. Domestic: Household Lawn & Garden Livestock Irrigation Feedlot Industrial

2. Public Water Supply: well ID

3. Dewatering: how many wells?

4. Aquifer Recharge: well ID

5. Monitoring: well ID

6. Environmental Remediation: well ID

7. Air Sparge Soil Vapor Extraction

8. Recovery Injection

9. Oil Field Water Supply: lease

10. Test Hole: well ID

11. Cased Uncased Geotechnical

12. Geothermal: how many bores?

13. a) Closed Loop Horizontal Vertical
 b) Open Loop Surface Discharge Inj. of Water

13. Other (specify):

Was a chemical/bacteriological sample submitted to KDHE? Yes No If yes, date sample was submitted:

Water well disinfected? Yes No

8 TYPE OF CASING USED: Steel PVC Other CASING JOINTS: Glued Clamped Welded Threaded
 Casing diameter 5 in. to 135 ft., Diameter in. to ft., Diameter in. to ft.
 Casing height above land surface 36 in. Weight lbs./ft. Wall thickness or gauge No.

TYPE OF SCREEN OR PERFORATION MATERIAL:
 Steel Stainless Steel Fiberglass PVC Other (Specify)
 Brass Galvanized Steel Concrete tile None used (open hole)

SCREEN OR PERFORATION OPENINGS ARE:
 Continuous Slot Mill Slot Gauze Wrapped Torch Cut Drilled Holes Other (Specify)
 Louvered Shutter Key Punched Wire Wrapped Saw Cut None (Open Hole)

SCREEN-PERFORATED INTERVALS: From 135 ft. to 155 ft., From ft. to ft., From ft. to ft.
GRAVEL PACK INTERVALS: From 155 ft. to 20 ft., From ft. to ft., From ft. to ft.

9 GROUT MATERIAL: Neat cement Cement grout Bentonite Other
 Grout Intervals: From 20 ft. to 0 ft., From ft. to ft., From ft. to ft.

Nearest source of possible contamination:
 Septic Tank Lateral Lines Pit Privy Livestock Pens Insecticide Storage
 Sewer Lines Cess Pool Sewage Lagoon Fuel Storage Abandoned Water Well
 Watertight Sewer Lines Seepage Pit Feedyard Fertilizer Storage Oil Well/Gas Well
 Other (Specify) Pasture well 999
 Direction from well? 999 Distance from well? 999 ft.

10 FROM	TO	LITHOLOGIC LOG	FROM	TO	LITHO. LOG (cont.) or PLUGGING INTERVALS
0	3	Sandy Top Soil			
3	42	Coarse Sand / Tan			
42	44	Tan Clay			
44	125	Fine Sand / Tan			
125	148	Coarse Sand			
148	155	Red Clay			
			Notes: <u>MUSTANG PASTURE</u>		

11 CONTRACTOR'S OR LANDOWNER'S CERTIFICATION: This water well was constructed, reconstructed, or plugged under my jurisdiction and was completed on (mo-day-year) 6-28-13 and this record is true to the best of my knowledge and belief. Kansas Water Well Contractor's License No. 672 This Water Well Record was completed on (mo-day-year) 7-15-13 under the business name of Crowdis Water Well