

WATER WELL RECORD Form WWC-5


Division of Water Resources App. No.

Well ID

Original Record Correction Change in Well Use

1 LOCATION OF WATER WELL: County: Comanche Fraction: 1/4 NW 1/4 NW 1/4 SE 1/4 Section Number: 8 Township Number: T 32 S Range Number: R 17 E W

2 WELL OWNER: Last Name: Zigler First: Zearl Street or Rural Address where well is located: From Colwater KS 90 East on Hwy 160 to 21 rd then 1/2 south & west to well

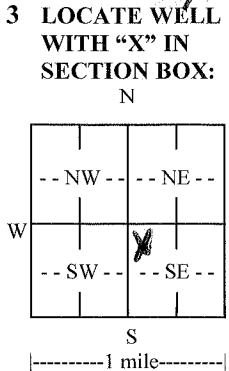

4 DEPTH OF COMPLETED WELL: 155 ft. Depth(s) Groundwater Encountered: 1) 53 ft. WELL'S STATIC WATER LEVEL: 53 ft.

5 Latitude: Longitude: Datum: Source for Latitude/Longitude: GPS (unit make/model):

6 Elevation: Source: Land Survey GPS Topographic Map Other

7 WELL WATER TO BE USED AS: 1. Domestic: Household, Lawn & Garden, Livestock, Irrigation, Feedlot, Industrial. 2. Public Water Supply, Dewatering, Aquifer Recharge, Monitoring, Environmental Remediation, Oil Field Water Supply, Test Hole, Geothermal, Other.

Was a chemical/bacteriological sample submitted to KDHE? No. Water well disinfected? Yes.

8 TYPE OF CASING USED: Steel PVC Other. CASING JOINTS: Glued Clamped Welded Threaded. Casing diameter: 5 in. to 135 ft. Diameter: 135 in. to 155 ft.

TYPE OF SCREEN OR PERFORATION MATERIAL: Steel Stainless Steel Fiberglass PVC Other. SCREEN OR PERFORATION OPENINGS ARE: Continuous Slot Mill Slot Gauze Wrapped Torch Cut Drilled Holes Other.

SCREEN-PERFORATED INTERVALS: From 135 ft. to 155 ft. GRAVEL PACK INTERVALS: From 155 ft. to 20 ft.

9 GROUT MATERIAL: Neat cement Cement grout Bentonite Other. Grout Intervals: From 20 ft. to 0 ft.

Nearest source of possible contamination: Septic Tank Lateral Lines Pit Privy Livestock Pens Insecticide Storage. Direction from well? 999 Distance from well? 999 ft.

Table with columns: 10 FROM, TO, LITHOLOGIC LOG, FROM, TO, LITHO. LOG (cont.) or PLUGGING INTERVALS. Rows: 0-12 Black top soil, 12-32 Red gravel, 32-40 Tan clay, 40-130 Fine sand tan, 130-150 coarse sand, 150-155 Red shale.

11 CONTRACTOR'S OR LANDOWNER'S CERTIFICATION: This water well was constructed, reconstructed, or plugged under my jurisdiction and was completed on (mo-day-year) 7-24-13.