


1 LOCATION OF WATER WELL: County: Comanche Fraction NW 1/4 SW 1/4 SW 1/4 Section Number 7 Township Number T 32 S Range Number R 18 E/W

Distance and direction from nearest town or city street address of well if located within city? Convenience Plus #8, 122 S Central - Coldwater, KS

2 WATER WELL OWNER: Wes-Kan Oil Co., Inc. RR#, St. Address, Box #: 130 W. Pancake City, State, ZIP Code: Liberal, Kansas 67901 Board of Agriculture, Division of Water Resources Application Number:

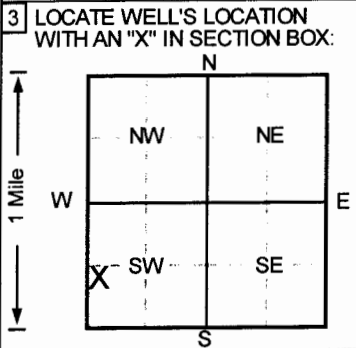

4 DEPTH OF COMPLETED WELL 65 ft. ELEVATION: 2106.3 ft. WELL'S STATIC WATER LEVEL 55.36 ft. below land surface measured on mo/day/yr 10/23/96. Pump test data: Well water was NA ft. after hours pumping gpm. Est. Yield NA gpm. Well water was ft. after hours pumping gpm. Bore Hole Diameter 8 in. to 65 ft., and in. to ft. WELL WATER TO BE USED AS: 5 Public water supply 8 Air conditioning 11 Injection well 1 Domestic 3 Feedlot 6 Oil field water supply 9 Dewatering 12 Other (Specify below) 2 Irrigation 4 Industrial 7 Lawn and garden only 10 Monitoring well. Was a chemical/bacteriological sample submitted to Department? Yes No. If yes, mo/day/yr sample was submitted Water Well Disinfected? Yes No

5 TYPE OF BLANK CASING USED: 1 Steel 2 PVC 3 RMP (SR) 4 ABS 5 Wrought iron 6 Asbestos-Cement 7 Fiberglass 8 Concrete tile 9 Other (specify below) CASING JOINTS: Glued Clamped Welded Threaded. TYPE OF SCREEN OR PERFORATION MATERIAL: 1 Steel 2 Brass 3 Stainless steel 4 Galvanized steel 5 Fiberglass 6 Concrete tile 7 PVC 8 RMP (SR) 9 ABS 10 Asbestos-cement 11 Other (specify) 12 None used (open hole) SCREEN OR PERFORATION OPENINGS ARE: 1 Continuous slot 2 Louvered shutter 3 Mill slot 4 Key punched 5 Gauzed wrapped 6 Wire wrapped 7 Torch cut 8 Saw cut 9 Drilled holes 10 Other (specify) 11 None (open hole) SCREEN-PERFORATED INTERVALS: FROM 45 ft. TO 65 ft. GRAVEL PACK INTERVALS: FROM 43 ft. TO 65 ft.

6 GROUT MATERIAL: 1 Neat cement 2 Cement grout 3 Bentonite 4 Other. Grout Intervals: FROM 0 ft. TO 41 ft., FROM 41 ft. TO 43 ft., FROM ft. TO ft. What is the nearest source of possible contamination: 1 Septic tank 2 Sewer lines 3 Watertight sewer lines 4 Lateral lines 5 Cess pool 6 Seepage pit 7 Pit privy 8 Sewage lagoon 9 Feedyard 10 Livestock pens 11 Fuel storage 12 Fertilizer storage 13 Insecticide storage 14 Abandoned water well 15 Oil well/Gas well 16 Other (specify below) UST Basin. Direction from well? SW How many feet? 370

Table with columns: FROM, TO, LITHOLOGIC LOG, FROM, TO, PLUGGING INTERVALS. Rows show depth intervals and lithology: 0-1 Gravel, 1-7 Sand, Brown, 7-22 Sand, Brown, 22-47 Sand, Brown, 47-65 Sand, Brown.

7 CONTRACTOR'S OR LANDOWNER'S CERTIFICATION: This water well was (1) constructed, (2) reconstructed, or (3) plugged under my jurisdiction and was completed on (mo/day/year) 10/18/96 and this record is true to the best of my knowledge and belief. Kansas Water Well Contractor's License No. 527 This Water Well Record was completed on (mo/day/yr) 11/18/96 under the business name of GeoCore Services, Inc. by (signature) Dale Robb