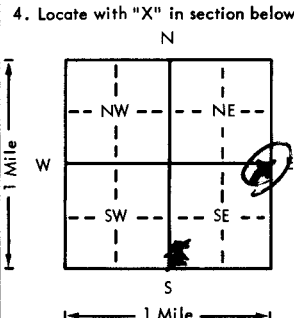


Sent 3-7-77

USE TYPEWRITER OR BALL POINT PEN-PRESS FIRMLY, PRINT CLEARLY.

WATER WELL RECORD
KSA 82a-1201-1215

Kansas Department of Health and Environment-Division of Environment (Water well Contractors) Topeka, Kansas 66620

1. Location of well:		County Comanche	Fraction NENESE NE 1/4 NE 1/4 SE 1/4	Section number 6	Township number T 32 S	Range number S R 18	W	
2. Distance and direction from nearest town or city: 1/2 mile North of Coldwater Street address of well location if in city:			3. Owner of well: Carl Yost R.R. or street: Coldwater, Kansas City, state, zip code:					
4. Locate with "X" in section below:		Sketch map: 			6. Bore hole dia. 9 3/8 in. Completion date _____ Well depth 196 ft. 2-25-77			
5. Type and color of material		From	To	7. <input type="checkbox"/> Cable tool <input checked="" type="checkbox"/> Rotary <input type="checkbox"/> Driven <input type="checkbox"/> Dug <input type="checkbox"/> Hollow rod <input type="checkbox"/> Jetted <input type="checkbox"/> Bored <input type="checkbox"/> Reverse rotary				
Very sandy top soil		0	2	8. Use: <input checked="" type="checkbox"/> Domestic <input type="checkbox"/> Public supply <input type="checkbox"/> Industry <input type="checkbox"/> Irrigation <input type="checkbox"/> Air conditioning <input type="checkbox"/> Stock <input type="checkbox"/> Lawn <input type="checkbox"/> Oil field water <input type="checkbox"/> Other				
Brown sandy silt		2	6	9. Casing: Material PI. Height: Above _____ below _____ Threaded _____ Welded _____ Surface 12 in. RMP _____ PVC <input checked="" type="checkbox"/> Weight _____ lbs./ft. Dia. 5 in. to 156 ft. depth Wall Thickness: inches or _____ Dia. _____ in. to _____ ft. depth gage No. CLASS 160				
Med. to to. sand & gravel		6	30	10. Screen: Manufacturer's name Certainfeed Type Plastic Dia. 5" Slot/gauze 1/8 Length 39' Set between 157 ft. and 196 ft. Gravel pack? yes Size range of material 1/2 x 3/8				
Gray clay		30	38	11. Static water level: _____ mo./day/yr. 75 ft. below land surface Date 2-25-77				
Med. to co. sand to med. co. gravel		38	53	12. Pumping level below land surfaces: _____ ft. after _____ hrs. pumping _____ g.p.m. _____ ft. after _____ hrs. pumping _____ g.p.m. Estimated maximum yield 75 g.p.m.				
Brown clay w/sand lenses		53	120	13. Water sample submitted: _____ mo./day/yr. Yes <input checked="" type="checkbox"/> No <input type="checkbox"/> Date _____				
Med. to co. sand to med. gravel		120	155	14. Well head completion: Top casing @ <input checked="" type="checkbox"/> Pitless adapter 12 inches above grade				
Brown clay		155	173	15. Well grouted? yes With: _____ Neoprene _____ Bentonite <input checked="" type="checkbox"/> Concrete Depth: From 12 ft. to 3 ft.				
Med. to coarse sand to med. co. gravel		173	195	16. Nearest source of possible contamination: _____ ft. 25 Direction SW Type Sewerline Well disinfected upon completion? <input checked="" type="checkbox"/> Yes _____ No				
Brown clay		195	200	17. Pump: <input checked="" type="checkbox"/> Not installed Manufacturer's name _____ Model number _____ HP _____ Volts _____ Length of drop pipe _____ ft. capacity _____ g.p.m. Type: <input type="checkbox"/> Submersible <input type="checkbox"/> Turbine <input type="checkbox"/> Jet <input type="checkbox"/> Reciprocating <input type="checkbox"/> Centrifugal <input type="checkbox"/> Other				
(Use a second sheet if needed)								
18. Elevation:	19. Remarks: Has a pitless adapter I cant concrete in discharge at 3', We were advised by your office at a meeting to stop concrete below discharge opening on a pitless adapter.			20. Water well contractor's certification: This well was drilled under my jurisdiction and this report is true to the best of my knowledge and belief. Layne Western Co. 102 Business name License No. _____ Address 1011 W. Harry, Wichita, Signed [Signature] Date 2-28-77 Authorized representative				

Sh 40
MAC

32
18
6
NE SE
1/4

Forward the white, blue and pink copies to the Department of Health and Environment

Form WWC-5